

LAND CORNER RECORDATION CERTIFICATE

FILING REQUIREMENT OF ACT 74, MICH. P.A.1970

FOR CORNERS OF--:	LOCATED IN--:	CORNER CODE NUMBER
1. PUBLIC LAND SURVEY	T. 27 N. R. 1 E.	D-9; D-8
2. PROPERTY CONTROLLING IN SECTION	20, T. 27 N. R. 1 E.	12
3. MISCELLANEOUS PROPERTY IN SECTION	, T. N. S., R. W.	
4. LOT NO. _____, RECORDED PLAT _____		
5. PRIVATE CLAIMS _____		

REGISTER OF DEEDS STAMP AND FILING NUMBER

I, KENNETH J. OSTLING, do hereby certify that under requirements of P.A. 74, Michigan P.A. of 1970, the corner points mentioned in lines 1 and 2 above were, in a field survey on FEBRUARY 7, 1983, established, re-established, monumented, re-monumented, recovered or restored as expressed below and in conformance with regulations and rules therefore as required in the current manual of survey instructions of the United States Department of the Interior, Bureau of Land Management or by a decree of a court of law. Furthermore, that the corner points mentioned in lines 3, 4 and 5 above were, in a field survey on _____, 19____, found, recovered, restored, established or re-established as expressed below and in conformance with the rules of the Michigan State Board of Registration for Land Surveyors or, by a Decree of a Court of law:

A. Description of original monument and accessories and/or subsequent restoration:

B. Description of corner evidence found and/or method applied in restoring or re-establishing corner:


- D-9 - SET CORNER BY SINGLE PROPORTIONATE MEASUREMENT BETWEEN SECTION CORNERS. SEELEY RECORD OF 1912 SURVEY SET CORNER M.P.O.L. AND NOTED SPECIFIC PHYSICAL FEATURES THAT ARE VERY COMPATIBLE WITH THIS CORNER LOCATION. UNABLE TO LOCATE PREVIOUS CORNER IN FROZEN MARSH. A 1" PIPE IS LOCATED SE'LY 166' FROM TRUE CORNER, BUT IS GROSSLY IN ERROR AND WAS DISREGARDED.
- 12 - SET CORNER BY STANDARD SURVEY PROCEDURE FOR THE SUBDIVISION OF SECTIONS.
- D-8 - SET CORNER BY STANDARD SURVEY PROCEDURE FOR THE SUBDIVISION OF SECTIONS, AT THE CALCULATED INTERSECTION OF THE TRUE 1/4 LINES.

C. Description of monument for corner and accessories established to perpetuate locating the position of the corner:

<u>D-9</u>			<u>12</u>		
SET DNR MONUMENT			SET 5/8" ROD WITH RLS CAP		
20" RED PINE	S65°W	128.8'	6" JACK PINE	N61°E	26.5'
7" RED PINE	N77°W	102.0'	12" JACK PINE	S48°W	56.0'

<u>D-8</u>		
SET 5/8" ROD WITH RLS CAP		
4" RED PINE	N69°E	23.4'
6" RED PINE	S65°E	34.1'

SIGNED BY *Kenneth J. Ostling* DATE 10-17-83
 SURVEYOR'S MICHIGAN REGISTRATION NO. 10068

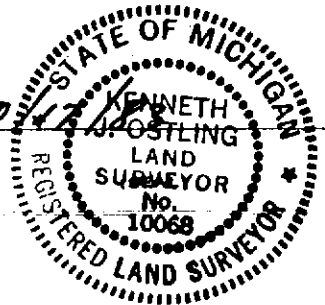

FOR STATE AND UNITED STATES AGENCIES:
 SIGNED BY _____ DATE _____
CHIEF OF SURVEY PARTY
 APPROVED AND SIGNED BY _____ DATE _____
MICHIGAN REGISTERED LAND SURVEYOR (SEAL)

SURVEYOR'S MICHIGAN REGISTRATION NO. _____ OSCODA COUNTY

MAY PLACE SKETCH ON BACK OR ATTACHED SHEET