

LAND CORNER RECORDATION CERTIFICATE

FILING REQUIREMENT OF ACT 74, MICH. P.A.1970

FOR CORNERS OF--:	LOCATED IN--:	CORNER CODE NUMBER
1. PUBLIC LAND SURVEY	T. 27 N. 0, R. 1 E. 0	A-11; B-11; C-11
2. PROPERTY CONTROLLING IN SECTION	T. N. S., R. E. W.	
3. MISCELLANEOUS PROPERTY IN SECTION	T. N. S., R. E. W.	
4. LOT NO. _____, RECORDED PLAT _____		
5. PRIVATE CLAIMS _____		

REGISTER OF DEEDS STAMP AND FILING NUMBER

I, Kenneth J. Ostling, do hereby certify that under requirements of P.A. 74, Michigan P.A. of 1970, the corner points mentioned in lines 1 and 2 above were, in a field survey on April 19 1977, established, re-established, monumented, re-monumented, recovered or restored as expressed below and in conformance with regulations and rules therefore as required in the current manual of survey instructions of the United States Department of the Interior, Bureau of Land Management or by a decree of a court of law. Furthermore, that the corner points mentioned in lines 3, 4 and 5 above were, in a field survey on _____, 19____, found, recovered, restored, established or re-established as expressed below and in conformance with the rules of the Michigan State Board of Registration for Land Surveyors or, by a Decree of a Court of law:

A. Description of original monument and accessories and/or subsequent restoration:


B. Description of corner evidence found and/or method applied in restoring or re-establishing corner:

- A-11 Found 1 1/4" pipe at corner possibly by M. Schaaf. Fits swamp edges and standard corner of Sec. 25 & 36 okay.
- B-11 Set corner by proportionate measurement between section corners. No evidence of previous corner.
- C-11 Found 1" iron bar at corner as established in previous survey by G. D. Henning.

C. Description of monument for corner and accessories established to perpetuate locating the position of the corner:

A-11	B-11	C-11
Set DNR monument in place of 1 1/4" pipe	Set DNR mon. & red-top post	Set DNR mon. in place of 1" iron bar
24" W. Pine N82°E 66.1	12" R. Pine N20°W 49.8	10" J. Pine S25°W 26.45
5" Birch S20°E 10.7	7" R. Pine East 44.95	10" R. Pine S71°E 54.10

SIGNED BY Kenneth J. Ostling DATE 6/7/77
 SURVEYOR'S MICHIGAN REGISTRATION NO. 10068

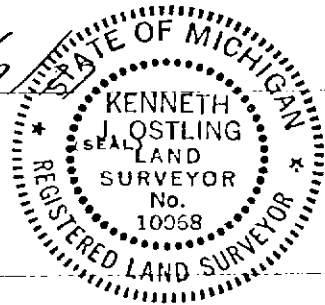

FOR STATE AND UNITED STATES AGENCIES:
 SIGNED BY _____ DATE _____
CHIEF OF SURVEY PARTY
 APPROVED AND SIGNED BY _____ DATE _____
MICHIGAN REGISTERED LAND SURVEYOR

SURVEYOR'S MICHIGAN REGISTRATION NO. _____ OSCODA COUNTY

MAY PLACE SKETCH ON BACK OR ATTACHED SHEET