

LAND CORNER RECORDATION CERTIFICATE

FILING REQUIREMENT OF ACT 74, MICH. P.A.1970

FOR CORNERS OF --:	LOCATED IN --:	CORNER CODE NUMBER
1. PUBLIC LAND SURVEY	T. 27 N. 1 E.	A-10; B-10; C-10
2. PROPERTY CONTROLLING IN SECTION 30	T. 27 N. 1 E.	8
3. MISCELLANEOUS PROPERTY IN SECTION	T. N. S. R. E. W.	
4. LOT NO. , RECORDED PLAT		
5. PRIVATE CLAIMS		

REGISTER OF DEEDS STAMP AND FILING NUMBER

I, Kenneth J. Ostling, do hereby certify that under requirements of P.A. 74, Michigan P.A. of 1970, the corner points mentioned in lines 1 and 2 above were, in a field survey on May 23, 1977, established, re-established, monumented, re-monumented, recovered or restored as expressed below and in conformance with regulations and rules therefore as required in the current manual of survey instructions of the United States Department of the Interior, Bureau of Land Management or by a decree of a court of law. Furthermore, that the corner points mentioned in lines 3, 4 and 5 above were, in a field survey on , 19 , found, recovered, restored, established or re-established as expressed below and in conformance with the rules of the Michigan State Board of Registration for Land Surveyors or, by a Decree of a Court of law:

A. Description of original monument and accessories and/or subsequent restoration:

B. Description of corner evidence found and/or method applied in restoring or re-establishing corner:

- A-10 Set corner by proportionate measure, midpoint on line, between section corners. Falls 498.8' south of E 1/4 Section 25, T27-1W.
- B-10 Set at calculated intersection of true 1/4 line, per standard survey procedure.
- C-10 Set by proportionate measurement between section corners - no previous corner.
- 8 Set by standard survey procedure for subdivision of sections.


C. Description of monument for corner and accessories established to perpetuate locating the position of the corner:

A-10	B-10	C-10
Set DNR mon. red-top post	Set 5/8" hex. rod w/RLS cap	Set DNR mon. red-top post
5" R. Pine N14°E 120.05	7" Twn. Birch N42°E 31.55	10" Maple N68°E 16.7
6" J. Pine S18°E 44.4	6" Tamarack S25°W 3.35	12" Oak S33°E 32.2
	Cedar post at corner	
		8
		Set 5/8" hex rod w/RLS cap
		10" Poplar N80°E 44.35
		8" Poplar S10°E 40.1

SIGNED BY *Kenneth Ostling* DATE 6/1/77
 SURVEYOR'S MICHIGAN REGISTRATION NO. 10068

FOR STATE AND UNITED STATES AGENCIES:

SIGNED BY _____ DATE _____
CHIEF OF SURVEY PARTY
 APPROVED AND SIGNED BY _____ DATE _____
MICHIGAN REGISTERED LAND SURVEYOR

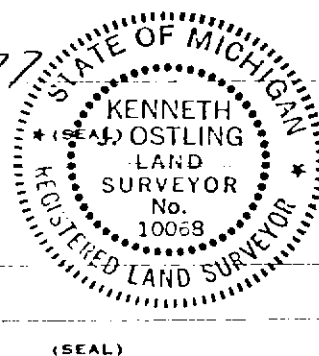

SURVEYOR'S MICHIGAN REGISTRATION NO. _____ OSCODA COUNTY