

# LAND CORNER RECORDATION CERTIFICATE

## FILING REQUIREMENT OF ACT 74, MICH. P.A.1970

FOR CORNERS OF--:	LOCATED IN--:	CORNER CODE NUMBER
1. PUBLIC LAND SURVEY.....	T..... N. S., R..... E. W.	.....
2. PROPERTY CONTROLLING IN SECTION- <u>33</u> .....	T. <u>27</u> ..... N. S., R. <u>1</u> ..... E. W.	<u>1</u> .....
3. MISCELLANEOUS PROPERTY IN SECTION.....	T..... N. S., R..... E. W.	.....
4. LOT NO. ...., RECORDED PLAT.....		
5. PRIVATE CLAIMS.....		

REGISTER OF DEEDS STAMP AND  
FILING NUMBER

I, KENNETH J. OSTLING, do hereby certify that under requirements of P.A. 74, Michigan P.A. of 1970, the corner points mentioned in lines 1 and 2 above were, in a field survey on DECEMBER 20, 1983, established, re-established, monumented, re-monumented, recovered or restored as expressed below and in conformance with regulations and rules therefore as required in the current manual of survey instructions of the United States Department of the Interior, Bureau of Land Management or by a decree of a court of law. Furthermore, that the corner points mentioned in lines 3, 4 and 5 above were, in a field survey on \_\_\_\_\_, 19\_\_\_\_, found, recovered, restored, established or re-established as expressed below and in conformance with the rules of the Michigan State Board of Registration for Land Surveyors or, by a Decree of a Court of law:

A. Description of original monument and accessories and or subsequent restoration:


B. Description of corner evidence found and/or method applied in restoring or re-establishing corner:  
1 - SET BY STANDARD SURVEY PROCEDURE FOR THE SUBDIVISION OF SECTIONS.

C. Description of monument for corner and accessories established to perpetuate locating the position of the corner:

<u>1</u>			
SET 5/8" ROD	W/RLS	CAP	
32" WHITE PINE	S63°W		8.7'
9" RED MAPLE	S60°E		28.0'
FENCE CORNER	N40°W		22.8'

SIGNED BY Kenneth J. Ostling  
SURVEYOR'S MICHIGAN REGISTRATION NO. 10068

DATE 10-27-84

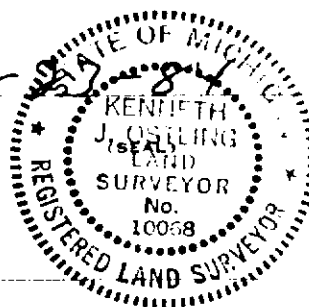

FOR STATE AND UNITED STATES AGENCIES:

SIGNED BY \_\_\_\_\_ DATE \_\_\_\_\_  
CHIEF OF SURVEY PARTY

APPROVED AND SIGNED BY \_\_\_\_\_ DATE \_\_\_\_\_  
MICHIGAN REGISTERED LAND SURVEYOR

SURVEYOR'S MICHIGAN REGISTRATION NO. ....

OSCODA COUNTY