

LAND CORNER RECORDATION CERTIFICATE
Filing Requirement of Act 74, Mich. P.A. 1970

For corners in

<u>Oscoda</u> <small>(County)</small>	Located In:	Corner Code #
1. Public Land Survey	T <u>27N</u> R <u>01E</u>	<u>A-4</u>
	T <u>27N</u> R <u>01E</u>	<u>B-4</u>
	T _____ R _____	_____
	T _____ R _____	_____
2. Property Controlling in Section	S <u>04</u> T <u>27N</u> R <u>01E</u>	<u>1</u>
	S _____ T _____ R _____	_____
3. Miscellaneous Property in Sec.	S _____ T _____ R _____	_____
	S _____ T _____ R _____	_____

Register of Deeds Stamp & File Number

4. Lot No. _____, Recorded Plat _____
 5. Private Claims _____

A	B	C	D	E	F	G	H	I	J	K	L	M
2	6		5		4		3		2		1	
3												
4	8		8		9		10		11		12	
5												
6	18		17		16		15		14		13	
7												
8	19		20		21		22		23		24	
9												
10	30		29		28		27		26		25	
11												
12	31		32		33		34		35		36	
13												

I, Carl R. Johnson, in a field survey on August 7, 19 89, do hereby certify that under requirements of P.A. 74, Michigan P.A. of 1970, the corner points mentioned in lines 1 and 2 above were in conformance with regulations and rules therefore as required in the current manual of survey instructions of the United States Department of the Interior, Bureau of Land Management or by a decree of a Court of Law and/or that the corner points mentioned in lines 3, 4 and 5 above were in conformance with the rules of the Michigan Board of Land Surveyors or by a Decree of a Court of Law; established, re-established, monumented, re-monumented, recovered, found as expressed below:

NOTE: Not more than 4 corners, all in the same town and range, may be recorded on this certificate.

A. Description of original monument and accessories and/or subsequent restoration:

B. Description of corner evidence found and/or method applied in restoring or reestablishing corner:

A-4 - Set corner midway between section corners and on township line.

B-4 - Set corner at computed intersection of $\frac{1}{4}$ lines.

1 - Set by standard procedure for subdivision of a section.


C. Description of monument for corner and accessories established to perpetuate locating the position of the corner:

A-4 - W $\frac{1}{4}$ Corner Sec. 7
 D.N.R. Monument
 10" J. Pine N70°W 23.1 ft
 8" J. Pine N55°E 24.7 ft
 4" Aspen S17°E 14.5 ft
 5" Aspen S26°W 17.9 ft

B-4 Center of Section 7
 D.N.R. Monument
 Nail & brass tag
 6" J. Pine N33°E 55.6 ft
 6" J. Pine N80°E 39.5 ft
 6" Cherry S23°E 66.4 ft
 4" J. Pine S36°W 18.5 ft

1 - W1/8, N. Side Sec. 4
 5/8" bar w/ cap
 14" R. Pine S70°E 61.5 ft
 6" R. Pine N38°E 51.7 ft
 6" J. Pine N30°W 40.1 ft
 38" Y. Pine Stp S32°W 54.0 ft
 Cedar post due south 17 ft

Signed by _____
 Surveyor's Michigan License No. 30083

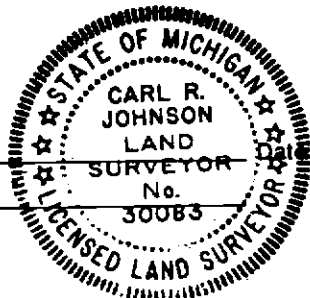

5/10/90