

LAND CORNER RECORDATION CERTIFICATE
Filing Requirement of Act 74, Mich. P.A. 1970

LIBER 3
 PAGE 65

For corners in

Oscoda
(County)

Located In: Corner Code //

- | | | | | | |
|------------------------------------|---|-----|---|----|-----|
| 1. Public Land Survey | T | 27N | R | 1E | A-7 |
| | T | | R | | |
| | T | | R | | |
| | T | | R | | |
| 2. Property Controlling in Section | S | T | R | | |
| | S | T | R | | |
| 3. Miscellaneous Property in Sec. | S | T | R | | |
| | S | T | R | | |

FILED

At 11:07 o'clock A M

Date June 6, 1990

PATRICIA WRIGHT
 Register of Deeds
 Oscoda County, Michigan

Register of Deeds Stamp & File Number

4. Lot No. _____, Recorded Plat _____
 5. Private Claims _____

Norman C. Caldwell in a field survey on March, 1990

do hereby certify that under requirements of P.A. 74, Michigan P.A. of 1970, the corner points mentioned in lines 1 and 2 above were in conformance with regulations and rules therefore as required in the current manual of survey instructions of the United States Department of the Interior, Bureau of Land Management or by a decree of a Court of Law and/or that the corner points mentioned in lines 3, 4 and 5 above were in conformance with the rules of the Michigan Board of Land Surveyors or by a Decree of a Court of Law; established, re-established, monumented, re-monumented, recovered, found as expressed below:

NOTE: Not more than 4 corners, all in the same town and range, may be recorded on this certificate.

1. Description of original monument and accessories and/or subsequent restoration:

- (A-7) Coon intersected 7.19 South of post & set post, Dec. 14, 1839.
 Y. Pine 20" S46°E .58 (38.28')
 Dwarf Oak 4" N13°E .72 (47.52')

2. Description of corner evidence found and/or method applied in restoring or reestablishing corner:


- (A-7) Fnd. 1" sq. iron bar placed by Caldwell, LS 12018, 1960+ over Shaaf pipe, Randall (Oscoda Co. Surveyor) post and remains of original post. (L 2 of surveys, pgs. 222-230 Henning, LS 2240) L 1, pg. 160, Fluharty, LS 18223), and L 1, pg 170, Henning, LS 2240).
 S16°E 33.46' Proj. Marker
 S24°W 38.18' 15" Oak
 N23°E 51.39' 9" Oak
 N50°W 50.38' P. Pole

NOTE: This is a "closing corner" and does not control alignment of the Michigan meridian.

3. Description of monument for corner and accessories established to perpetuate locating the position of the corner:

- (A-7) Sec. cor. 18&19, T27N-R1E
 Fnd. 1" sq. bar placed by LS 12018 over Shaaf (LaGuire) pipe and Randall post, and remains of orig. post, in CL E-W pav't and fireline N-S. And is accepted as a careful & faithful perpetuation of the position of the original corner.
 S45°E 46.7' Carsonite Witness Post & 1/2" bar w/LS 2240 cap
 N45°W 50.2' P. Pole (R)
 N35°E 62.9' 4" N. Pine
 S30°E 54.9' P. Pole
 S20°E 33.5' conc. proj. marker (R)
 S20°W 38.2' 14" Oak (R)

	A	B	C	D	E	F	G	H	I	J	K	L	M
2	6	5	4	3	2								
3													
4	7	8	9	10	11	12							
5													
6	18	17	16	15	14	13							
7	19	20	21	22	23	24							
8													
9													
10	30	29	28	27	26	25							
11													
12	31	32	33	34	35	36							
13													

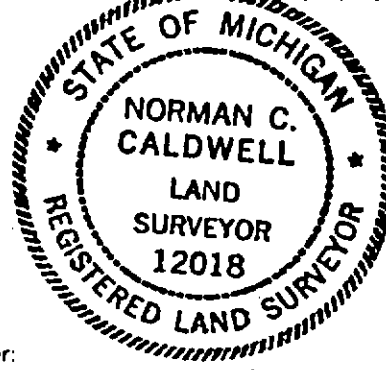

signed by Norman C. Caldwell

Date April 26, 1990

Surveyor's Michigan License No. 12018