LAND CORNER RECORDATION CERTIFICATE

Filing Requirement of Act 74, Mich. P.A. 1970

LIBER 3
PAGE 64

FILED

At 11:08 o'clock A M

Date June 6 1990

PATRICIA WRIGHT
Register of Deeds
Oscoda County, Michigan

Register of Deeds Stamp & File Number

or corners in

Oscoda (County)

Located In: Corner Code 11

Public Land Survey		T27N R 1E	A-8
		T R	
		T R	
		T R	
Property Controlling	S	T R	
in Section	S	T R	
Miscellaneous	S	T R	
Property in Sec.	S	T R	

Lot No. _____, Recorded Plat _____

Private Claims _____

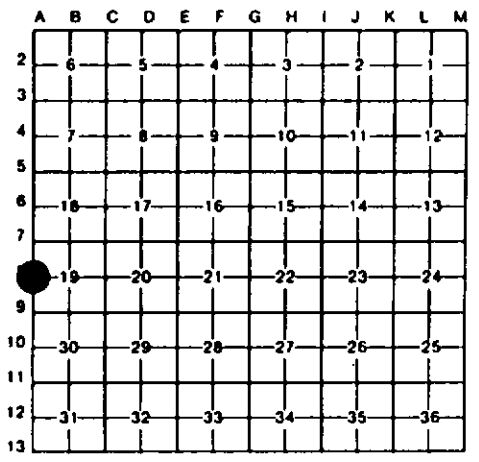

Norman C. Caldwell, in a field survey on March, 19 90, do hereby certify that under requirements of P.A. 74, Michigan P.A. of 1970, the corner points mentioned in lines 1 and 2 above were in conformance with regulations and rules therefore as required in the current manual of survey instructions of the United States Department of the Interior, Bureau of Land Management or by a decree of a Court of Law and/or that the corner points mentioned in lines 3, 4 and 5 above were in conformance with the rules of the Michigan Board of Land Surveyors or by a Decree of a Court of Law; established, re-established, monumented, re-monumented, recovered, found as expressed below:

NOTE: Not more than 4 corners, all in the same town and range, may be recorded on this certificate.

Description of original monument and accessories and/or subsequent restoration:

(A-8) Original government survey did not establish this position.

Description of corner evidence found and/or method applied in restoring or reestablishing corner:

(A-8) 1/2" bar placed by LS 2240 in survey of record (L 2 of surveys, pgs 222-230), (corner record in L 1, pg 170)
N61°W 11.3' 10" W. Oak
S15°W 36.5' 8" R. Oak
S20°E 53.6' 14" R. Oak
Was established using improper procedures.

NOTE: This is a "closing corner" and does not control alignment of the Michigan Meridian.

Description of monument for corner and accessories established to perpetuate locating the position of the corner:

(A-8) 1/4 cor. Sec. 19, T27N-R1E

Fnd. 1/2" bar w/LS 2240 cap in CL N-S fireline & groomed snowmobile trail
East 33' Carsonite Witness Post S20°E 16.7' 15" Oak (R)
East 33.0' 1/2" bar
N60°W 11.4' 12" W. Oak (R)
N60°W 25.4' 5" N. Pine
S15°W 36.5' 10" Oak (R)
West 5.4' Red Top Post

STATE OF MICHIGAN
NORMAN C. CALDWELL
LAND SURVEYOR
12018
REGISTERED LAND SURVEYOR

Signed by Norman C. Caldwell Date April 26, 1990

Surveyor's Michigan License No. 12018

FORM APPROVED BY MICHIGAN STATE BOARD OF LAND SURVEYORS, JAN. 28, 1971
REVISED MAY 14, 1975
REVISED JAN., 1983