

LAND CORNER RECORDATION CERTIFICATE
Filing Requirement of Act 74, Mich. P.A. 1970

LIBER 3
PAGE 67

or corners in _____

Oscoda Located In: _____ Corner Code # _____
(County)

Public Land Survey T 27N R 1E A-9
 T _____ R _____
 T _____ R _____
 T _____ R _____

Property Controlling S _____ T _____ R _____
 in Section S _____ T _____ R _____

Miscellaneous S _____ T _____ R _____
 Property in Sec. S _____ T _____ R _____

FILED

At 11:09 o'clock A M

Date June 6 1990

PATRICIA WRIGHT
 Register of Deeds
 Oscoda County, Michigan

Register of Deeds Stamp & File Number

Lot No. _____, Recorded Plat _____
 Private Claims _____

	A	B	C	D	E	F	G	H	I	J	K	L	M
2	6	5	4	3	2	1							
3													
4	7	8	9	10	11	12							
5													
6	18	17	16	15	14	13							
7													
8	19	20	21	22	23	24							
9													
10	30	29	28	27	26	25							
11													
12	31	32	33	34	35	36							
13													

Norman C. Caldwell in a field survey on March 19 90

I hereby certify that under requirements of P.A. 74, Michigan P.A. of 1970, the corner points mentioned in lines 1 and 2 above were in conformance with regulations and rules therefore as required in the current manual of survey instructions of the United States Department of the Interior, Bureau of Land Management or by a decree of a Court of Law and/or that the corner points mentioned in lines 3, 4 and 5 above were in conformance with the rules of the Michigan Board of Land Surveyors or by a Decree of a Court of Law; established, re-established, monumented, re-monumented, recovered, found as expressed below:

NOTE: Not more than 4 corners, all in the same town and range, may be recorded on this certificate.

Description of original monument and accessories and/or subsequent restoration:

A-9) Coon intersected 8.02 links South of post & set post, Dec. 14, 1839.
 Spruce pine 15" N37°E .92 (60.72')
 Y. Pine 20" S18°E .38 (25.08')

Description of corner evidence found and/or method applied in restoring or reestablishing corner:

A-9) C.O. Seeley, Feb. 3, 1913, fnd. original government corner and BTs marked NBT WP stub 30" N58°E 80.5'
 Carlos LaGuire, (DNR) 1934 fnd. a well point (no witness trees) corner recorded in L. 1, pg 178 & L. 1, pg 170.


NOTE: This is a "closing corner" and does not control alignment of the Michigan Meridian.

Description of monument for corner and accessories established to perpetuate locating the position of the corner:

A-9) Sec. cor. 19&30, T27N-R1E
 Fnd. DNR Pipe & Cap along West edge fireline, no evidence of original corner or well point. And is accepted as a careful and faithful perpetuation of the position of the original corner.
 South 1' Carsonite Witness Post West 4.7' 5" W. Pine
 N35°E 28.4' 6" W. Pine
 S70°E 25.6' 5" W. Pine
 S35°E 44.1' 10" J. Pine (Old BT)

Witnessed by Norman C. Caldwell

Surveyor's Michigan License No. 12018

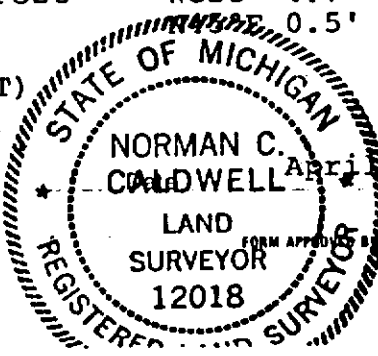

June 26, 1990