

LAND CORNER RECORDATION CERTIFICATE
Filing Requirement of Act 74, Mich. P.A. 1970

LIBER 3
PAGE 69
FILED

For corners in

Oscoda Located In: Corner Code: 11
(County)

1. Public Land Survey T 27N R 1E A-11
T R
T R
T R

2. Property Controlling S T R
in Section S T R

3. Miscellaneous S T R
Property in Sec. S T R

At 11:11 o'clock A M
Date June 6, 1990
PATRICIA WRIGHT
Register of Deeds
Oscoda County, Michigan

Register of Deeds Stamp & File Number

4. Lot No. _____, Recorded Plat _____
5. Private Claims _____

| | A | B | C | D | E | F | G | H | I | J | K | L | M |
|----|----|----|----|----|----|----|---|---|---|---|---|---|---|
| 2 | 6 | 5 | 4 | 3 | 2 | 1 | | | | | | | |
| 3 | | | | | | | | | | | | | |
| 4 | 7 | 8 | 9 | 10 | 11 | 12 | | | | | | | |
| 5 | | | | | | | | | | | | | |
| 6 | 18 | 17 | 16 | 15 | 14 | 13 | | | | | | | |
| 7 | | | | | | | | | | | | | |
| 8 | 19 | 20 | 21 | 22 | 23 | 24 | | | | | | | |
| 9 | | | | | | | | | | | | | |
| 10 | 30 | 29 | 28 | 27 | 26 | 25 | | | | | | | |
| 11 | | | | | | | | | | | | | |
| 12 | 31 | 32 | 33 | 34 | 35 | 36 | | | | | | | |
| 13 | | | | | | | | | | | | | |

Norman C. Caldwell in a field survey on March, 1990
do hereby certify that under requirements of P.A. 74, Michigan P.A. of 1970, the corner points mentioned in lines 1 and 2 above were in conformance with regulations and rules therefore as required in the current manual of survey instructions of the United States Department of the Interior, Bureau of Land Management or by a decree of a Court of Law and/or that the corner points mentioned in lines 3, 4 and 5 above were in conformance with the rules of the Michigan Board of Land Surveyors or by a Decree of a Court of Law; established, re-established, monumented, re-monumented, recovered, found as expressed below:

NOTE: Not more than 4 corners, all in the same town and range, may be recorded on this certificate.

A. Description of original monument and accessories and/or subsequent restoration:

(A-11) Coon intersected 7.93 links South of post & set post, Dec. 14, 1839.
Tamarack 6" N45°E .10 (6.60')
Cedar 8" S55°E .22 (14.52')

B. Description of corner evidence found and/or method applied in restoring or reestablishing corner:

(A-11) DNR pipe & cap placed by K.J. Ostling, LS 10068 to replace pipe by Schaaf, April 19, 1977.
N82°E 66.1' 24" W. Pine
S20°E 10.7' 5" Birch


NOTE: This is a "closing corner" and does not control alignment of the Michigan Meridian.

C. Description of monument for corner and accessories established to perpetuate locating the position of the corner:

(A-11) Sec. cor. 30&31, T27N-R1E
Fnd. DNR pipe w/cap, old Shaaf pipe & block along side (South), orig. BT fnd. to SE. And is accepted as a careful and faithful perpetuation of the position of the original corner.
North 0.5' Carsonite Witness Post S70°W 18.7' 5" Spruce
S45°W 1.0' Red Top Post S55°E 14.5' orig. BT (Cedar) down but blaze good
N82°E 67.2' 24" W. Pine (R)
S20°E 11.0' 6" W. Birch (R)
N15°E 19.0' 6" Spruce

Signed by

Surveyor's Michigan License No. 12018

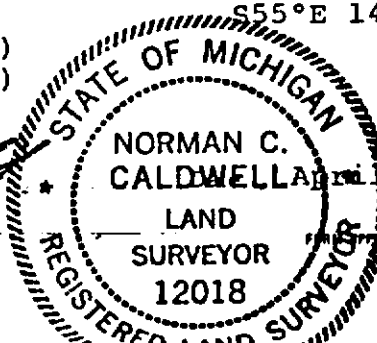

June 26, 1990