

LAND CORNER RECORDATION CERTIFICATE
 Filing Requirement of Act 74, Mich. P.A. 1970

LIBER 3
 PAGE 15

For corners in

Oscoda
 (County)

Located In:

Corner Code #/

- | | | | |
|------------------------------------|---------------|--------------|------|
| 1. Public Land Survey | T <u>27</u> N | R <u>1</u> E | C-10 |
| | T | R | |
| | T | R | |
| | T | R | |
| 2. Property Controlling in Section | S | T | R |
| | S | T | R |
| 3. Miscellaneous Property in Sec. | S | T | R |
| | S | T | R |

FILED

At 11:17 o'clock A M

Date June 6, 1990

PATRICIA WRIGHT
 Register of Deeds
 Oscoda County, Michigan

Register of Deeds Stamp & File Number

1. Lot No. _____, Recorded Plat _____
 2. Private Claims _____

	A	B	C	D	E	F	G	H	I	J	K	L	M
2	6	5	4	3	2	1							
3													
4	7	8	9	10	11	12							
5													
6	18	17	16	15	14	13							
7													
8	19	20	21	22	23	24							
9													
10	30	29	28	27	26	25							
11													
12	31	32	33	34	35	36							
13													

Norman C. Caldwell in a field survey on March, 1990

to hereby certify that under requirements of P.A. 74, Michigan P.A. of 1970, the corner points mentioned in lines 1 and 2 above were in conformance with regulations and rules theretofore as required in the current manual of survey instructions of the United States Department of the Interior, Bureau of Land Management or by a decree of a Court of Law and/or that the corner points mentioned in lines 3, 4 and 5 above were in conformance with the rules of the Michigan Board of Land Surveyors or by a Decree of a Court of Law; established, re-established, monumented, re-monumented, recovered, found as expressed below:

NOTE: Not more than 4 corners, all in the same town and range, may be recorded on this certificate.

1. Description of original monument and accessories and/or subsequent restoration:

- (C-10) Post set by Coon, Dec. 14, 1839.
 Tamarack 6" S29 1/2°W .19 (12.54')
 Tamarack 10" N28°W .24 (15.84')

2. Description of corner evidence found and/or method applied in restoring or reestablishing corner:


- (C-10) DNR pipe & cap placed by LS 10068 May 23, 1977, L 1, pg 177
 N68°E 16.7' 10" Maple
 S33°E 32.2' 12" Oak

3. Description of monument for corner and accessories established to perpetuate locating the position of the corner:

- (C-10) 1/4 cor. 29&30, T27N-R1E
 Fnd. rec. DNR pipe & cap. Accepted as a careful & faithful reestablishment of the position of original corner.
 North 1' Carsonite Witness Post East 2.6' Red Top Post
 N68°E 17.0' 10" Maple (old BT)
 S33°E 32.3' 12" Oak (old BT)
 S70°W 52.3' 10" Oak
 N60°W 36.4' 10" Maple

Signed by Norman C. Caldwell

Surveyor's Michigan License No. 12018

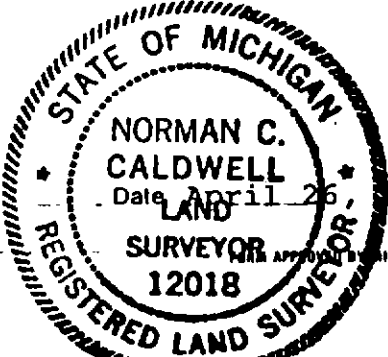

APPROVED BY _____
 MICHIGAN STATE BOARD OF LAND SURVEYORS, JAN. 28, 1971
 REVISED MAY 14, 1975
 REVISED JAN., 1983