

LAND CORNER RECORDATION CERTIFICATE
 Filing Requirement of Act 74, Mich. P.A. 1970

LIBER 3
 PAGE 77

or corners in

Oscoda Located In: Corner Code 11
(County)

Public Land Survey T 27N R 1E C-12
 T _____ R _____
 T _____ R _____
 T _____ R _____

Property Controlling S _____ T _____ R _____
 in Section S _____ T _____ R _____
 Miscellaneous S _____ T _____ R _____
 Property in Sec. S _____ T _____ R _____

FILED
 At 11:19 o'clock A.M
 Date June 12 1990
 PATRICIA WRIGHT
 Register of Deeds
 Oscoda County, Michigan
 Register of Deeds Stamp & File Number

Lot No. _____, Recorded Plat _____
 Private Claims _____

	A	B	C	D	E	F	G	H	I	J	K	L	M
2	6	5	4	3	2	1							
3													
4	7	8	9	10	11	12							
5													
6	18	17	16	15	14	13							
7													
8	19	20	21	22	23	24							
9													
10	30	29	28	27	26	25							
11													
12	31	32	33	34	35	36							
13													

Norman C. Caldwell in a field survey on March, 1990,
 I hereby certify that under requirements of P.A. 74, Michigan P.A. of 1970, the corner points mentioned
 in lines 1 and 2 above were in conformance with regulations and rules therefore as required in the
 current manual of survey instructions of the United States Department of the Interior, Bureau of Land
 Management or by a decree of a Court of Law and/or that the corner points mentioned in lines 3, 4 and 5
 above were in conformance with the rules of the Michigan Board of Land Surveyors or by a Decree of a
 Court of Law; established, re-established, monumented, re-monumented, recovered, found as
 expressed below:

NOTE: Not more than 4 corners, all in the same town and range, may be recorded
 on this certificate.

Description of original monument and accessories and/or subsequent restoration:

(C-12) Post set by Coon, Dec. 13, 1839.
 Spruce Pine 4" N61°W .14 (9.24')
 Spruce Pine 6" S62°E .18 (11.88')

Description of corner evidence found and/or method applied in restoring or reestablishing corner:

(C-12) 1/2" bar placed by Henning, LS 2240, & survey recorded in L 2, pg 186-195.


Description of monument for corner and accessories established to perpetuate locating the position of the corner:

(C-12) 1/4 cor. 31&32, T27N-R1E

Fnd. 1/2" bar. Accepted as a careful
 & faithful reestablishment of the
 position of the original corner.

North 1' Carsonite Witness Post East 34.0' Carsonite Witness Post
 S40°W 33.7' 8" Oak (Old BT)
 N40°W 25.4' 8" Oak (Old BT)
 N40°E 23.7' 10" Oak (Old BT)
 East 33.0' 1/2" bar w/2240 cap

signed Norman C. Caldwell
 Surveyor's Michigan License No. 12018

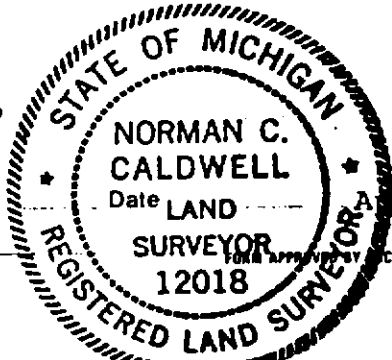

Date LAND April 26, 1990