

LAND CORNER RECORDATION CERTIFICATE
Filing Requirement of Act 74, Mich. P.A. 1970

For corners in

OSCODA

(County)

Located In:

Corner Code ##

- | | | |
|------------------------------------|-----------------------------|-------------|
| 1. Public Land Survey | T <u>27N</u> R <u>1E</u> | <u>D-10</u> |
| | T _____ R _____ | _____ |
| | T _____ R _____ | _____ |
| | T _____ R _____ | _____ |
| 2. Property Controlling in Section | S <u>29</u> T _____ R _____ | <u>8</u> |
| | S <u>29</u> T _____ R _____ | <u>4</u> |
| 3. Miscellaneous Property in Sec. | S _____ T _____ R _____ | _____ |
| | S _____ T _____ R _____ | _____ |
4. Lot No. _____, Recorded Plat _____
5. Private Claims _____

Register of Deeds Stamp & File Number

I, CARL R. JOHNSON, in a field survey on JANUARY 29, 19 92, do hereby certify that under requirements of P.A. 74, Michigan P.A. of 1970, the corner points mentioned in lines 1 and 2 above were in conformance with regulations and rules therefore as required in the current manual of survey instructions of the United States Department of the Interior, Bureau of Land Management or by a decree of a Court of Law and/or that the corner points mentioned in lines 3, 4 and 5 above were in conformance with the rules of the Michigan Board of Land Surveyors or by a Decree of a Court of Law, established, re-established, monumented, re-monumented, recovered, found as expressed below:

NOTE: Not more than 4 corners, all in the same town and range, may be recorded on this certificate.

A. Description of original monument and accessories and/or subsequent restoration:

D-10

8

4

	A	B	C	D	E	F	G	H	I	J	K	L	M
2	6	5	4	3	2	1							
3													
4	7	8	9	10	11	12							
5													
6	13	17	16	15	14	13							
7													
8	19	20	21	22	23	24							
9													
10	30	●	●	28	27	26	25						
11													
12	31	32	33	34	35	36							
13													

B. Description of corner evidence found and/or method applied in restoring or reestablishing corner:

D-10

8

4

SET AT COMPUTED INTERSECTION OF 1/4 LINES.

SET BY STANDARD SURVEY PROCEDURE FOR SUBDIVISION OF A SECTION.

SET BY STANDARD SURVEY PROCEDURE FOR SUBDIVISION OF A SECTION.

C. Description of monument for corner and accessories established to perpetuate locating the position of the corner:

D-10

8

4

CENTER OF SEC. 29
3/4" IRON PIPE W/CAP


W1/8 COR. ON E-W 1/4 LINE
5/8" BAR W/CAP

CENTER OF NW 1/4
5/8" BAR W/CAP

R. OAK 8" S03N 60.5 FT.
FE. POST S56E 35.6 FT.
FE. POST S77W 60.3 FT.
CEDAR POST WEST 1.5 FT.

N. PINE 10" S45E 17.4 FT.
MAPLE 12" S08E 21.2 FT.
MAPLE 8" WEST 26.3 FT.

MAPLE 7" N74N 18.6 FT.
MAPLE 5" S24N 8.3 FT.
N. PINE 3" S56E 8.4 FT.
R. PINE 3" N61E 14.1 FT.

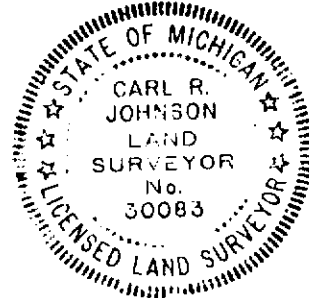

Signed by

Carl R. Johnson

Date

3/17/92

Surveyor's Michigan License No.

30083