

27/1

LAND CORNER RECORDATION CERTIFICATE

Filing Requirement of Act 74, Mich. P.A. 1970

Liber 4 pg. 56

For corners in Oscoda (County)

Located In: Corner Code #

26N 16 2E M-13

Table with 4 columns: Survey Type, T, R, Corner Code #. Rows include Public Land Survey, Property Controlling in Section, Miscellaneous Property in Section.

STATE OF MICHIGAN OSCODA COUNTY FILED

2 AUG 95 9:34 A.M.

PATSY J. PETERS REGISTER OF DEEDS

Register of Deeds Stamp & File Number

4. Lot No. , Recorded Plat
5. Private Claims

Grid table with columns A-L and rows 1-13.

I, Marvin E. Myers in a field survey on May 19, 1995 do hereby certify that under requirements of P.A. 74, Michigan P.A. of 1970, the corner points mentioned in lines 1 and 2 above were in conformance with regulations and rules therefore as required in the current manual of survey instructions of the United States Department of the Interior, Bureau of Land Management or by a decree of a Court of Law and/or that the corner points mentioned in lines 3, 4 and 5 above were in conformance with the rules of the Michigan Board of Professional Surveyors or by a Decree of a Court of Law; established, re-established, monumented, re-monumented, recovered, found as expressed below:

NOTE: Not more than 4 corners, all in the same town and range, may be recorded on this certificate.

A. Description of original monument and accessories and/or subsequent restoration:

- List of monuments and accessories including GLO-L. Clawson May 1834, GLO-G. Veal Oct. 1935, L.2 of Plats, pg.9 G.D. Henning July 26, 1957, Fargo Engineering 1908-1909, G.F. Delamater Feb. 24, 1924, G.D. Henning May 7, 1941, L.3, pg.425 E.J. McCombs May 10, 1984.

B. Description of corner evidence found and/or method applied in restoring or reestablishing corner:

Found 1" pipe in centerline County Road 606 and Townline the 1"x1 1/2" pipe is over USGLO monument with brass cap. Accepted as a perpetuation of the Original Government corner.


APPROVED

County Remonumentation Peer Review Group

NCC/31 Aug 9, JOU

C. Description of monument for corner and accessories established to perpetuate locating the position of the corner:

- List of monuments for corner including Mon-USGLO monument in Pav't box, WIT: Fd. PK Nail S36°E 1.65', Fd. Conc. Mon. S36°E 46.84', Fd. cabin spike W. face 19" B.Oak S11°E 93.34', USFS Location post N47°E 44.59', Fd. cabin spike E. face 19" B.Oak N27°W, Set spike in E. face 12" W.Pine S28°W 104.25', Set spike NW face 19" B.Oak N28°E 99.83'

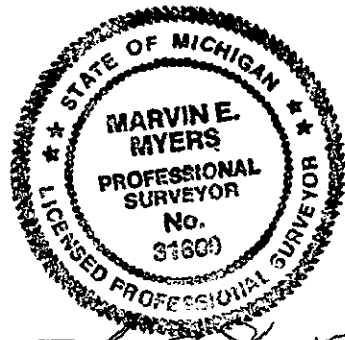

Signed by Marvin E. Myers

Date July 28, 1995

Surveyor's Michigan License No. 31600