DEC 21 2000

SECTION

LAND CORNER RECORDATION CERTIFICATE
Filing Requirement of Act 74, Mich. P.A. 1970

For corners in

Oscoda
(County)

Liber 5 Pg 81

STATE OF MICHIGAN
OSCODA COUNTY
FILED

9 AUG 2000 3:23:26 PM

PATSY J. PETERS
REGISTER OF DEEDS

Register of Deeds Stamp & File Number

		Located In:	Corner Code #
1. Public Land Survey		T 27N R 2E	A-6
		T 27N R 1E	M-6
		T ____ R ____	
		T ____ R ____	
2. Property Controlling	S ____	T ____ R ____	
in Section	S ____	T ____ R ____	
3. Miscellaneous	S ____	T ____ R ____	
Property in Sec.	S ____	T ____ R ____	

4. Lot No. _____ , Recorded Plat _____
5. Private Claims_____

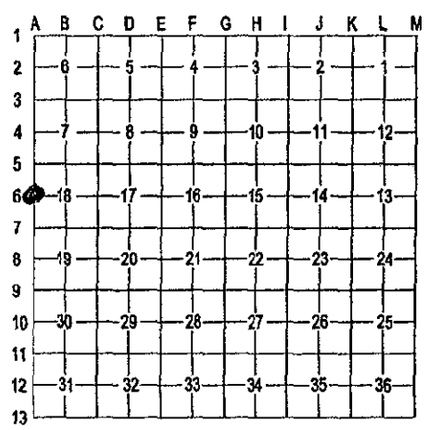

I, Marvin E. Myers , in a field survey on June 8, 2000 do hereby state that under requirements of P.A. 74, Michigan P.A. of 1970, the corner points mentioned in lines 1 and 2 above were in conformance with *regulations and rules therefore as required in the current manual of survey instructions of the United States* Department of the Interior, Bureau of Land Management or by a decree of a Court of Law and /or that the corner points mentioned in lines 3, 4 and 5 above were in conformance with the rules of the Michigan Board of Land Surveyors or by a Decree of a Court of Law; established, re-established, monumented, recovered, found as expressed below:

NOTE: Not more than 2 corners, all in the same town and range, may be recorded on this certificate.

A. Description of original monument and accessories and/or subsequent restoration

¼ corner common to Section 13, T27N, R1E and Section 18, T27N, R2E

G.L.O.-1839 Lewis Clason D.S.
Mon - Post
Wit: 4" Spr. Pine S66°W 16 lks
4" Spr. Pine N11°W 14 lks

July 1885 J. Randall, CS
Mon - *Remarked Post*
Identified Spruce SW legible
Hollow NW
Wit: 3" Dwarf Oak N35¾°W 76¾ Lks
4" Spruce S87°E 317½ lks

1968 Consumers Power Co. H.W. Dorcey
Mon – Apparently set but did not recorded
monument history or accessories

LCRC L 1, P 116, April 1973
N. Caldwell, PS 12018
Mon – Found Consumers Power Co. "T" Iron and replaced with Standard County Corner.
Wit: 12" Norway Pine N30°E 56.4
16" N. Pine S60°E 56.8
D.N.R. Marker Post East 33.0'

B. Description of corner evidence found and/or method applied in restoring or reestablishing corner:

¼ corner common to Section 13, T27N, R1E and Section 18, T27N, R2E

Found Standard County Corner in centerline of N-S Road; All accessories destroyed by construction. Accepted Standard County Corner as the best available evidence of the Position of the Original Government Corner.

C. Description of monument for corner and accessories established to perpetuate locating the position of the corner:

¼ corner common to Section 13, T27N, R1E and Section 18, T27N, R2E

Mon-Standard County Corner monument.
Wit: Spike in S. side 4" J. Pine S80°W 28.30
Spike in N. side 16" Norway N55°E 70.50
Spike in N. side 16" Norway S40°E 75.03
Spike in S. side 4" B. Oak N35°W 43.00

APPROVED
County Remonumentation
Peer Review Group
NCC
27 JULY 00

STATE OF MICHIGAN
MARVIN E. MYERS
PROFESSIONAL SURVEYOR
No. 31600
LICENSED PROFESSIONAL SURVEYOR

Signed by Marvin E. Myers

Date July 10, 2000

Surveyor's Michigan License No. 31600

FORM APPROVED BY MICHIGAN STATE BOARD OF PROFESSIONAL SURVEYORS, JAN. 28, 1
REVISED MAY 14, 1
REVISED JAN., 1
REVISED OCT., 1