

DEC 21 2000

SECTION

LAND CORNER RECORDATION CERTIFICATE
Filing Requirement of Act 74, Mich. P.A. 1970

For corners in

Oscoda
(County)

Located In:

Corner Code #

- 1. Public Land Survey T 27N R 2E D-1
- T _____ R _____
- T _____ R _____
- T _____ R _____
- 2. Property Controlling S _____ T _____ R _____
- in Section S _____ T _____ R _____
- 3. Miscellaneous S _____ T _____ R _____
- Property in Sec. S _____ T _____ R _____

- 4. Lot No. _____, Recorded Plat _____
- 5. Private Claims _____

I, Marvin E. Myers, in a field survey on 2000 do hereby state that under requirements of P.A. 74, Michigan P.A. of 1970, the corner points mentioned in lines 1 and 2 above were in conformance with regulations and rules therefore as required in the current manual of survey instructions of the United States Department of the Interior, Bureau of Land Management or by a decree of a Court of Law and /or that the corner points mentioned in lines 3, 4 and 5 above were in conformance with the rules of the Michigan Board of Land Surveyors or by a Decree of a Court of Law; established, re-established, monumented, recovered, found as expressed below:

NOTE: Not more than 2 corners, all in the same town and range, may be recorded on this certificate.

A. Description of original monument and accessories and/or subsequent restoration.

Closing N ¼ corner Section 5, T27N, R2E

Not Set by GLO Marcus Schaff circa 1930's 1969 Kenneth J. Ostling #10068
 Found, or established and replaced Mon. - Found 1 1/2" Pipe This corner was established at midpoint be section corners of Section 5 on the standard townline. Set Dept. Mon 17.4 East of S ¼ of Section 32.
 Wit: 10" J. Pine S50°W 55.8'
 7" R. Pine S80°E 67.1'

B. Description of corner evidence found and/or method applied in restoring or reestablishing corner:

Closing N ¼ corner Section 5, T27N, R2E


Found 1 1/2" Pipe with ineligible cap inside. Accepted Pipe as a careful and faithful establishment of the position of the Government Corner. Drove bar down inside pipe and set Standard Oscoda County Remonumentation cap inside pipe.

C. Description of monument for corner and accessories established to perpetuate locating the position of the corner:

Closing N ¼ corner Section 5, T27N, R2E

Mon - 1 1/2" pipe with Standard Oscoda County Monument inside.
 Wit: D-13 N80°W 17.40
 Nail W. side N25°E 9" J. Pine 44.80
 Center of "Nancy Brown Road" sign post N45°E 28.29
 Stop sign post S88°W 56.72
 S. edge of "Richard Road" signpost N64°W 46.14

APPROVED
 County Remonumentation
 Peer Review Group
 NCC
 27 JULY 00

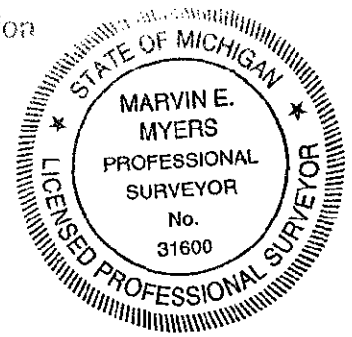

Signed by Marvin E. Myers
 Surveyor's Michigan License No. 31600

Date July 10, 2000

Liber 5 pg. 92
 STATE OF MICHIGAN
 OSCODA COUNTY
 FILED
 9 AUG 2000 3:33:04 PM
 PATSY J. PETERS
 REGISTER OF DEEDS
 Register of Deeds Stamp & File Number

	A	B	C	D	E	F	G	H	I	J	K	L	M
1													
2	6		5		4		3		2		1		
3													
4	7		8		9		10		11		12		
5													
6	18		17		16		15		14		13		
7													
8	19		20		21		22		23		24		
9													
10	30		29		28		27		26		25		
11													
12	31		32		33		34		35		36		
13													