

DEC 21 2000

SECTION

LAND CORNER RECORDATION CERTIFICATE  
Filing Requirement of Act 74, Mich. P.A. 1970

Liber 5 pgs. 97-98

STATE OF MICHIGAN  
OSCODA COUNTY  
FILED

9 AUG 2000 3:39:03 PM

PATSY J. PETERS  
REGISTER OF DEEDS

Register of Deeds Stamp & File Number

For corners in

Oscoda

(County)

Located In:

Corner Code #

1. Public Land Survey

T 27N R 2E

E-2

T R

T R

T R

2. Property Controlling  
in Section

S T R

S T R

3. Miscellaneous  
Property in Sec.

S T R

S T R

4. Lot No. \_\_\_\_\_, Recorded Plat \_\_\_\_\_

5. Private Claims \_\_\_\_\_

I, Marvin E. Myers, in a field survey on June 29, 2000 do hereby state that under requirements of P.A. 74, Michigan P.A. of 1970, the corner points mentioned in lines 1 and 2 above were in conformance with regulations and rules therefore as required in the current manual of survey instructions of the United States Department of the Interior, Bureau of Land Management or by a decree of a Court of Law and for that the corner points mentioned in lines 3, 4 and 5 above were in conformance with the rules of the Michigan Board of Land Surveyors or by a Decree of a Court of Law; established, re-established, monumented, recovered, found as expressed below:

NOTE: Not more than 2 corners, all in the same town and range, may be recorded on this certificate.

A. Description of original monument and accessories and/or subsequent restoration.

1/4 corner common to Sections 4 and 5, T27N, R2E

G.L.O. 1839 William R. Coon

1887 John Randall, CS

Mon - Post

Mon - Post

Wit: 5" Dwarf Oak S34°W 61 lks Wit: 14" Y Pine S11E 37 1/2

5" Dwarf Oak N78°W 10 1/2 lks 8" Spr. Pine West 45

B. Description of corner evidence found and/or method applied in restoring or reestablishing corner:

1/4 corner common to Sections 4 and 5, T27N, R2E

No evidence of corner or subsequent restoration was found, reestablished corner by single proportion measure between E-1 and E-3. Set 5/8"x3/4" steel rebar with Standard Oscoda County Remonumentation Cap. This position was accepted as a careful and faithful reestablishment of the position of the Government Corner.

C. Description of monument for corner and accessories established to perpetuate locating the position of the corner:

1/4 corner common to Sections 4 and 5, T27N, R2E

Mon - Standard Oscoda County Monument.

Wit: Set nail & tag NW side 12" J. Pine N31°E 7.04


Set nail & tag N. side 12" Norway N74°E 21.62

Set nail & tag E. side 10" J. Pine S06°E 21.40

Set nail & tag N. side 8" J. Pine S72°W 28.95

APPROVED  
County Remonumentation  
Peer Review Group

NCC  
27 JULY 00

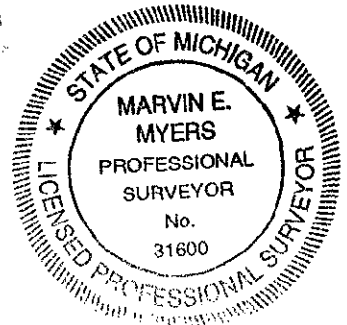

Signed by

Marvin E. Myers

Date July 11, 2000

Surveyor's Michigan License No. 31600

DEC 21 2000

SECTION

NOTE: FOR EAST AND WEST CONTROL  
SEE SHEET D-3 OR F-3

