

SECTION

LAND CORNER RECORDATION CERTIFICATE
Filing Requirement of Act 74, Mich. P.A. 1970

For corners in

OSCODA Located In: ELMER Corner Code # _____
(County)

1. Public Land Survey T 27N R 2E _____ E-9
T _____ R _____
T _____ R _____
T _____ R _____

2. Property Controlling S _____ T _____ R _____
in Section S _____ T _____ R _____

3. Miscellaneous S _____ T _____ R _____
Property in Sec. S _____ T _____ R _____

Liber 5 pg 69

STATE OF MICHIGAN
OSCODA COUNTY
FILED

15 SEP 1999 9:50:17 AM


PATSY J. PETERS
REGISTER OF DEEDS

Register of Deeds Stamp & File Number

4. Lot No. _____, Recorded Plat _____
5. Private Claims _____

I, FREDERICK J. KING, in a field survey on JUNE 8, 1999 do hereby state that under requirements of P.A. 74, Michigan P.A. of 1970, the corner points mentioned in lines 1 and 2 above were in conformance with regulations and rules therefore as required in the current manual of survey instructions of the United States Department of the Interior, Bureau of Land Management or by a decree of a Court of Law and/or that the corner points mentioned in lines 3, 4 and 5 above were in conformance with the rules of the Michigan Board of Land Surveyors or by a Decree of a Court of Law; established, re-established, monumented, recovered, found as expressed below:

NOTE: Not more than 2 corners, all in the same town and range, may be recorded on this certificate.

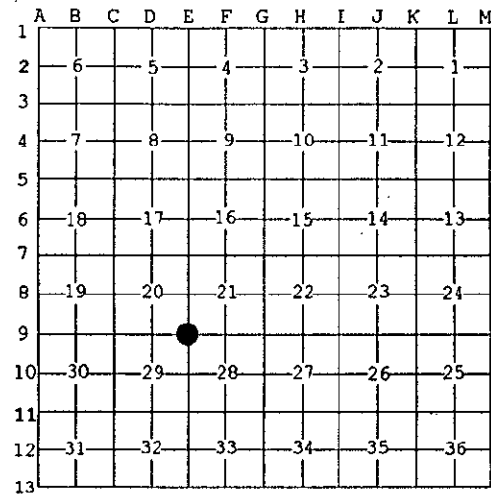

A. Description of original monument and accessories and/or subsequent restoration:

- E-9 - CORNER COMMON TO SECTIONS 20, 21, 28 & 29
- Nov. 1839 - William R. Coon, Dep Sur. - Set Original Post * N8°W-13 lks (8.58') 12" Pine * S8°E-56 lks (36.96') 16" Pine
 - Oct. 1965 - Field Notes of N.C. Caldwell, PS#12018 - States he set Cor. 5517.6' East of Cor. C-9 - No Wit
 - June 1969 - Sec Div Sur by H.W. Dorsey, PS#9429 for Cons Pwr. CO. - Fnd Iron Pipe * SW-62.86' - Norway * NW-41.67'-16" Oak SE-29.93' - Fnc Cor Post
 - Sept 1973 - Act 132 by N.C. Caldwell, PS#12018 - Fnd Rec 1/2" Pipe-Set Std CO. Cor. * N45°W-50.3'-14" Oak * S40°W-62.9' 14" N. Pine * S30°E-29.9'- Fnc Cor Post (R) * N50°E-59.9' - 8" Apple (Rec. L. 1, Pg. 387)
 - Aug. 1976 - Act 132 by N.C. Caldwell, PS#12018 - Shows Cor Used - No Desc - No wit (Rec. L.2, Pg. 269)
 - May 1978 - Act 132 by N.C. Caldwell, PS#12018 -Shows Cor Used - No Desc - No Wit (Rec. L.2, Pg. 589)
 - Sept. 1978 - Act 74 by N.C. Caldwell, PS#12018 - Same Info as L. 1, Pg.387 (Rec. Bk 1, Pg. 205)
 - March 1981 - Act 132 by F.J. King, PS#25852 - Fnd Std CO Cor. * N30°E-39.95'- P. Pole * S20°E-39.62'- P. Pole * S45°W-65.18'-10" Pop * N50°W-26.6'-ST. Sign Post (Rec. L.3, Pg. 409)
 - Oct. 1993 - Act 132 by F.J. King, PS#25852 - Fnd Rec. Std CO Corner (Refers to Bk 1, Pg. 205) (Rec. L. 193, Pg. 7298)

B. Description of corner evidence found and/or method applied in restoring or reestablishing corner:

E-9 - CORNER COMMON TO SECTIONS 20, 21, 28 & 29
Fnd Rec. Std Co. Corner & Wit Rec. L.193, Pg. 7298

APPROVED

County Remonumentation
Peer Review Group

SEPT 9 9
NCC

THIS CORNER APPROVED BY OSCODA COUNTY PEER REVIEW ON JULY 9, 1999, AS A CAREFUL AND FAITHFUL ESTABLISHMENT OF THE POSITION OF THE CORNER.

C. Description of monument for corner and accessories established to perpetuate locating the position of the corner:

E-9 - CORNER COMMON TO SECTIONS 20, 21, 28 & 29

- Record Standard Oscoda County Corner
- N30°E - 40.06' (R-39.95') Set S&T on W side of P. Pole #1990
 - N50°E - 59.7' (R-59.9') SW Face of 10" Apple (Now Dead)
 - S30°E - 29.9' (R-29.9' & 29.93') Fnc Cor Post (Rotted Off)
 - S25°E - (R-S20°E) 39.62' - Set S&T on W side of P. Pole
 - S20°W - 68.47' - Set S&T on W side of 24" Oak
 - N45°W (R-N50°W) - 30.74' (R-26.6') - SE Cor St Sign Post (At Grnd)
 - Corner Is 4' N of C.L. of E-W Gravel Rd. (Kneeland Rd.)
 - Corner Is - 2' E of C.L. of Gravel Rd. to N (Richardson Rd.)

Signed by Frederick J. King
Surveyor's Michigan License No. 25852

Date August 28, 1999

