

SECTION

LAND CORNER RECORDATION CERTIFICATE  
Filing Requirement of Act 74, Mich. P.A. 1970

For corners in

<u>OSCODA</u> (County)	Located in: ELMER	Corner Code #
1. Public Land Survey	T <u>27N</u> R <u>2E</u>	<u>E-10</u>
	T <u>    </u> R <u>    </u>	<u>    </u>
	T <u>    </u> R <u>    </u>	<u>    </u>
	T <u>    </u> R <u>    </u>	<u>    </u>
2. Property Controlling in Section	S <u>    </u> T <u>    </u> R <u>    </u>	<u>    </u>
	S <u>    </u> T <u>    </u> R <u>    </u>	<u>    </u>
3. Miscellaneous Property in Sec.	S <u>    </u> T <u>    </u> R <u>    </u>	<u>    </u>
	S <u>    </u> T <u>    </u> R <u>    </u>	<u>    </u>

Liber 5 pg 70

STATE OF MICHIGAN  
OSCODA COUNTY  
FILED

15 SEP 1999 9:51:08 AM

PATSY J. PETERS  
REGISTER OF DEEDS

Register of Deeds Stamp & File Number

4. Lot No. \_\_\_\_\_, Recorded Plat \_\_\_\_\_  
5. Private Claims \_\_\_\_\_

I, FREDERICK J. KING, in a field survey on JUNE 10, 1999 do hereby state that under requirements of P.A. 74, Michigan P.A. of 1970, the corner points mentioned in lines 1 and 2 above were in conformance with regulations and rules therefore as required in the current manual of survey instructions of the United States Department of the Interior, Bureau of Land Management or by a decree of a Court of Law and /or that the corner points mentioned in lines 3, 4 and 5 above were in conformance with the rules of the Michigan Board of Land Surveyors or by a Decree of a Court of Law, established, re-established, monumented, recovered, found as expressed below:

NOTE: Not more than 2 corners, all in the same town and range, may be recorded on this certificate.

A	B	C	D	E	F	G	H	I	J	K	L	M
1												
2	6		5		4		3		2		1	
3												
4	7		8		9		10		11		12	
5												
6	18		17		16		15		14		13	
7												
8	19		20		21		22		23		24	
9												
10	30		29		28		27		26		25	
11												
12	31		32		33		34		35		36	
13												

A. Description of original monument and accessories and/or subsequent restoration:

E-10 - 1/4 CORNER COMMON TO SECTIONS 28 & 29

Nov. 1839 - William R. Coon - Dep. Sur. - Set Original Post \* N39°W-93 lks (61.38') 8" Pine \* S81°E-1.15 ch-(75.90') 8"  
June 1966 - Survey by H.W. Dorsey, PS#9429 for Cons Pwr Co. Indicated, that he set corner by single Prop between E-9 & E-10  
No Corner Desc. - No witnesses.

B. Description of corner evidence found and/or method applied in restoring or reestablishing corner:

E-10 - 1/4 CORNER COMMON TO SECTIONS 28 & 29

No Corner Found - Propose to set Cor by Single Prop between Corners E-9 & E-11

APPROVED

County Remonumentation  
Peer Review Group


1 SEPT 99  
NCC

THIS CORNER APPROVED BY OSCODA COUNTY PEER REVIEW ON JULY 9, 1999, AS A CAREFUL AND FAITHFUL ESTABLISHMENT OF THE POSITION OF THE CORNER.

C. Description of monument for corner and accessories established to perpetuate locating the position of the corner:

E-10 - 1/4 CORNER COMMON TO SECTIONS 28 & 29

Set 1/2" Iron (Wrapped with Elec. Tape) and Oscoda County Re-mon Cap.  
On line and at Mid-Point between Corners E-9 & E-11 With Carsonite Marker Post Alongside  
N15°E - 20.00' - Set S&T on E side of 6" Maple  
S80°E - 10.37' - Set S&T on S side of 12" Oak  
S15°W - 12.85' - Set S&T on E side of 5" W. Pine  
N70°W - 4.13' - Set S&T on N side of 15" Oak  
Corner Is - 123' E of N-S Pwr Line

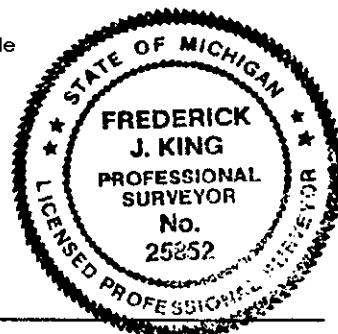

Signed by Frederick J. King  
Surveyor's Michigan License No. 25852

Date August 28, 1999