

**SURVEY &
REMONUMENTATION**

MAR 19 1997

COMMISSION

**LAND CORNER RECORDATION CERTIFICATE
Filing Requirement of Act 74, Mich. P.A. 1970**

For corners in <u>Oscoda</u> <small>(County)</small>	Located In:	Corner Code #
1. Public Land Survey	T <u>27N</u> R <u>2E</u>	<u>E - 13</u>
	T _____ R _____	_____
	T _____ R _____	_____
	T _____ R _____	_____
2. Property Controlling in Section	S _____ T _____ R _____	_____
	S _____ T _____ R _____	_____
3. Miscellaneous Property in Section	S _____ T _____ R _____	_____
	S _____ T _____ R _____	_____

Liber 4 Pg 149

STATE OF MICHIGAN
OSCODA COUNTY
FILED

26 NOV 96 3:04 P.M.

PATSY J. PETERS
REGISTER OF DEEDS

Register of Deeds Stamp & File Number

4. Lot No. _____, Recorded Plat _____
5. Private Claims _____

A	B	C	D	E	F	G	H	I	J	K	L	N
2	6	5	4	3	2	1						
3												
4	7	8	9	10	11	12						
5												
6	18	17	16	15	14	13						
7												
8	19	20	21	22	23	24						
9												
10	30	29	28	27	26	25						
11												
12	31	32	33	34	35	36						
13												

I, Marvin E. Myers, in a field survey on June 27, 19 96, do hereby certify that under requirements of P.A. 74, Michigan P.A. of 1970, the corner points mentioned in lines 1 and 2 above were in conformance with regulations and rules therefore as required in the current manual of survey instructions of the United States Department of the Interior, Bureau of Land Management or by a decree of a Court of Law and/or that the corner points mentioned in lines 3, 4 and 5 above were in conformance with the rules of the Michigan Board of Professional Surveyors or by a Decree of a Court of Law; established, re-established, monumented, re-monumented, recovered, found as expressed below:

NOTE: Not more than 4 corners, all in the same town and range, may be recorded on this certificate.

A. Description of original monument and accessories and/or subsequent restoration:

GLO - Clason Mon. - Post WIT: 7" Y.Pine N35°W 38 lks. 40" Y.Pine N38°E 61 lks.	1909 Fargo Eng. Mon. - Unknown WIT: Unknown	Liber 3, pg. 106 Norman Caldwell Aug. 1979 Mon. - Unknown WIT: P.P. N40°E 69.5' Sec. cor. 4-5 West 8.18' Fence cor. South 34.2'
May 14, 1885 John Randall Mon. - Remark post Fd. post & both US BT's WIT: NBT 8" Y.Pine S29½°W 2.03'	GLO - 1935 Guy Veal Mon. - Set Brass Tablet in 6" conc. at the intersection of roads N-E-W WIT: 10" Poplar N85 3/4°E 304 lks. 2" Thorn N60½°W 64 lks.	Liber 1, pg. 227 Norman Caldwell Sept. 1979 Mon. - Unknown WIT: P.P. N40°E 69.5' Sec. cor. 4-5 West 8.18' Fence cor. South 34.2'

B. Description of corner evidence found and/or method applied in restoring or reestablishing corner:


Found ½" bar in pavement box
Found P.P. N40°E 69.5'
And is accepted as a careful and faithful reestablishment of the position of the original corner
Standard Corner Sections 32 & 33, T27N, R2E

APPROVED
County Remonumentation
Peer Review Group

*Rec
16 Nov 96*

C. Description of monument for corner and accessories established to perpetuate locating the position of the corner:

Replaced record ½" Bar with Standard Oscoda County Monument in pav't box
WIT: Nail in cor. fence post S83°W 134.55'
Nail in W. side 3" Thornapple N38°W 66.99'
Nail NW side utility pole N52°E 69.50'(R)
Nail E. side utility pole S10°W 44.96'

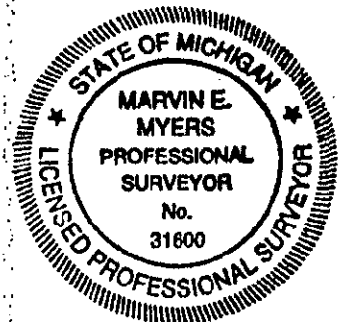

Signed by Marvin E. Myers
Surveyor's Michigan License No. 31600

Date September 7, 1996