

**SURVEY &
REMONUMENTATION**

501

OCT 07 1999

LAND CORNER RECORDATION CERTIFICATE
Filing Requirement of Act 74, Mich. P.A. 1970

For corners in

SECTION

<u>Oscoda</u> (County)	Located In:	Corner Code #
1. Public Land Survey	Sec. <u>T 27NR 2E</u>	<u>G-7</u>
	Sec. T ___ R ___	_____
	T ___ R ___	_____
	T ___ R ___	_____
2. Property Controlling in Section	S ___ T ___ R ___	_____
	S ___ T ___ R ___	_____
3. Miscellaneous Property in Sec.	S ___ T ___ R ___	_____
	S ___ T ___ R ___	_____
4. Lot No. _____, Recorded Plat _____		
5. Private Claims _____		

STATE OF MICHIGAN
OSCODA COUNTY
FILED

3 SEP 1999 1:42:00 PM

PATSY J. PETERS
REGISTER OF DEEDS

Register of Deeds Stamp & File
Number

Liber 5 Page 22

I, Marvin E. Myers, in a field survey on June 22, 1999 do hereby state that under requirements of P.A. 74, Michigan P.A. of 1970, the corner points mentioned in lines 1 and 2 above were in conformance with regulations and rules therefore as required in the current manual of survey instructions of the United States Department of the Interior, Bureau of Land Management or by a decree of a Court of Law and /or that the corner points mentioned in lines 3, 4 and 5 above were in conformance with the rules of the Michigan Board of Land Surveyors or by a Decree of a Court of Law; established, re-established, monumented, recovered, found as expressed below:

NOTE: Not more than 2 corners, all in the same town and range, may be recorded on this certificate.

A	B	C	D	E	F	G	H	I	J	K	L	M
1												
2	6		5		4		3		2		1	
3												
4	7		8		9		10		11		12	
5												
6	18		17		16		15		14		13	
7												
8	19		20		21		22		23		24	
9												
10	30		29		28		27		26		25	
11												
12	31		32		33		34		35		36	
13												

A. Description of original monument and accessories and/or subsequent restoration:

G-7 = Corner common to Sections 15, 16, 21, & 22, T27N, R2E
 GLO Nov 1839 William R. Coon, DS June 17th, 1968 N. Caldwell #12018
 Mon - Post Mon - Found record 1/2" Pipe
 Wit: 4" Aspen N8°W 12 lks Wit: 6" Maple N39°W 112.3'
 5" Aspen S10°E 6 lks 12" Maple S11°W 105.0'

1930's± M. Schaaf Mar. 19, 1985 F. J. King #25852
 Mon - Fd. Or Est. and replaced Mon - Fd. 3/4" Pipe in Mon. Box
 Wit: none given In center of pav't

Mar 25th 1992 Oscoda Co.
 Road Commission
 Mon: Placed Mon Box
 Wit: Set 1/2" bar N45°E 50.00
 Set 1/2" bar S45°W 50.00

C.P.Co Nov. 1967 H. W. Dorsey L 5, P 14 May 16th, 1991 L. Beauregard #18654
 Mon - Fd. Iron pipe Mon - Ex. 1/2" Pipe in Mon. Box
 Wit: Nail N. side P. Pole SE 81.29' Wit: Placed nail & tag P. Pole South 31.71'
 Nail S. side P. Pole NE 84.35' Placed nail & tag P. Pole N45°E 109.30'
 Nail N. side T. Pole SW 52.96 Placed nail & tag P. Pole S60°W 109.3
 6" Maple S11°W 105.0' @ NCC
 15" Maple N39°W 112.3' @ NCC

L196, P 8054 Dec 13th 1996
 L. Beauregard #18654
 Mon - Ex. 1/2" Pipe in Mon. box
 Wit: same as L5, P.14

B. Description of corner evidence found and/or method applied in restoring or reestablishing corner:

G-7 = Corner common to Sections 15, 16, 21, & 22, T27N, R2E
 Mon - Found Pavement monument box with top sealed (unable to remove cover with out damaging monument box.)
 Left monument box in place accepted positions as the best available evidence of the position of the Original Government Corner.
 Wit: Found 1/2" bar N48°E 49.90
 Found nail & tag #18654 in NW side of Utility Pole N50°E 83.95
 Found Dept of Conservation location post South 33.0
 Found nail & tag in E. side Utility Pole South 31.71


APPROVED

County Remonumentation
Peer Review Group

19 AUG 99 NCC

C. Description of monument for corner and accessories established to perpetuate locating the position of the corner:

G-7 = Corner common to Sections 15, 16, 21, & 22, T27N, R2E
 Mon - Pavement monument box left in place unable to open.
 Wit: Nail N. side of Utility Pole S68°W 109.62
 Mag Nail S. side Utility Pole N63°W 122.10
 1/2" bar N48°E 49.90
 Nail & tag E. side Utility Pole South 31.71

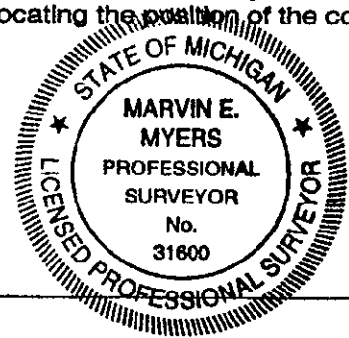

Signed by *Marvin E. Myers*
 Surveyor's Michigan License No. 31600

Date July 9, 1999