

**SURVEY &  
REMONUMENTATION**

OCT 17 1999

**LAND CORNER RECORDATION CERTIFICATE**  
Filing Requirement of Act 74, Mich. P.A. 1970

**SECTION**

STATE OF MICHIGAN  
OSCODA COUNTY  
FILED

3 SEP 1999 1:44:14 PM

PATSY J. PETERS  
REGISTER OF DEEDS

Register of Deeds Stamp & File  
Number

*Liber 5 Page 24*

	A	B	C	D	E	F	G	H	I	J	K	L	M
1													
2	6	5	4	3	2								
3													
4	7	8	9	10	11	12							
5													
6	18	17	16	15	14	13							
7													
8	19	20	21	22	23	24							
9													
10	30	29	28	27	26	25							
11													
12	31	32	33	34	35	36							
13													

For corners in

<u>Oscoda</u> (County)	Located In:	Corner Code #
		<u>G-9</u>
1. Public Land Survey	Sec. <u>T 27N R 2E</u>	<u>                    </u>
	Sec. <u>                    </u>	<u>                    </u>
	<u>                    </u>	<u>                    </u>
	<u>                    </u>	<u>                    </u>
2. Property Controlling in Section	S <u>                    </u>	<u>                    </u>
	S <u>                    </u>	<u>                    </u>
3. Miscellaneous Property in Sec.	S <u>                    </u>	<u>                    </u>
	S <u>                    </u>	<u>                    </u>
4. Lot No. <u>                    </u> , Recorded Plat <u>                    </u>		
5. Private Claims <u>                    </u>		

I, Marvin E. Myers, in a field survey on June 22, 1999 do hereby state that under requirements of P.A. 74, Michigan P.A. of 1970, the corner points mentioned in lines 1 and 2 above were in conformance with regulations and rules therefore as required in the current manual of survey instructions of the United States Department of the Interior, Bureau of Land Management or by a decree of a Court of Law and for that the corner points mentioned in lines 3, 4 and 5 above were in conformance with the rules of the Michigan Board of Land Surveyors or by a Decree of a Court of Law; established, re-established, monumented, recovered, found as expressed below:

**NOTE: Not more than 2 corners, all in the same town and range, may be recorded on this certificate.**

A. Description of original monument and accessories and/or subsequent restoration:

G-9 Corner common to Sections 21, 22, 27, & 28, T27N, R2E  
GLO Nov 1839 William R. Coon, DS C.P.Co Nov. 1967 H. W. Dorsey #9429  
Mon - Fd. Iron pipe  
Wit: 12" Elm N25°E 34.75  
14" w. Pine S45°W 66.55  
Nail SW side 4" Norway SE 46.17

Mar. 19, 1985 F. J. King #25852  
Mon - Fd. Std. Co. Cor.  
Wit: Record Bk. 1, P206

Co. Surveyor Book 1, Page 215  
Oct 1, 1887 J. Randall Co. Surveyor  
Mon - U.S.  
Wit: none given

June 6, 1968 N. Caldwell #12018  
Mon - Fd. Large Stone & Pipe  
placed 3 large stones around Cor.  
Wit: 12" Elm N25°E 34.75  
14" W. Pine S45°W 66.55

Sept. 25, 1990 F. J. King #25852  
Mon - Fd. Rec. Cor.  
Wit: Rec. Bk. 1, P206

Co. Surveyor Book 2, Page 17  
Aug 29<sup>th</sup> 1911 C. Seeley, Co. Surveyor  
Mon - unknown  
Wit: Fd. Old US bearing tree

L2, P 601 N. Caldwell #12018  
June 1, 1978  
Mon - Fd. Iron replaced with Std.  
Co. Mon. on this date  
Wit: 18" W. Pine S45°W 56.2  
6" N. Pine S45°E 46.6  
12" Elm N40°E 34.5  
1/2" bar & Cap North 33.00  
LORC L1, P. 206 N. Caldwell #12018  
Same as above.

**APPROVED**

County Remonumentation  
Peer Review Group


*19 AUG 99*  
*NCC*

B. Description of corner evidence found and/or method applied in restoring or reestablishing corner:

G-9 Corner common to Sections 21, 22, 27, & 28, T27N, R2E  
Mon - Found 1/2" Bar 3' North of Centerline  
Wit: Found 18" (now 30") W. Pine S45°W 56.2  
Found 6" N. Pine (Now 10") Norway S39°E (recorded as S45°E) 46.6  
Accepted 1/2" bar as a perpetuation of the Original Government Corner. Replaced 1/2" bar with 5/8" bar with Standard Oscoda County Cap.

C. Description of monument for corner and accessories established to perpetuate locating the position of the corner:

G-9 Corner common to Sections 21, 22, 27, & 28, T27N, R2E  
Mon - 5/8" rebar with Standard County cap  
Wit: Spike in E. side 4" Balsam N31°E 26.6'  
Spike in E. side 4" Poplar N23°W 28.08'  
Spike in W. side 4" Balsam S56°W 46.90'  
10" Norway S39°E 46.6'

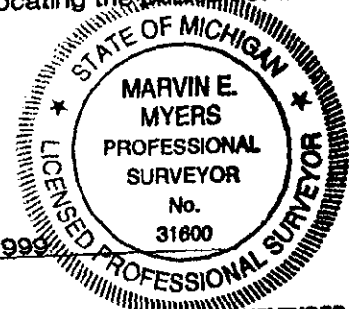

Signed by Marvin E. Myers  
Surveyor's Michigan License No. 31600

Date August 14, 1999