

SURVEY & REMONUMENTATION **LAND CORNER RECORDATION CERTIFICATE**
 Filing Requirement of Act 74, Mich. P.A. 1970

For corners in Oscoda Located In: _____ Corner Code # _____
 (County) **MAR 19 1997**

Liber 4 pg 152

STATE OF MICHIGAN
 OSCODA COUNTY
 FILED

26 NOV 96 3:07 P.M.

PATSY J. PETERS
 REGISTER OF DEEDS

- COMMISSION**
- Public Land Survey T 27N R 2E H - 13
 T _____ R _____
 T _____ R _____
 T _____ R _____
 - Property Controlling in Section S _____ T _____ R _____
 S _____ T _____ R _____
 - Miscellaneous Property in Section S _____ T _____ R _____
 S _____ T _____ R _____
 - Lot No. _____, Recorded Plat _____
 - Private Claims _____

Register of Deeds Stamp & File Number

I, Marvin E. Myers, in a field survey on June 28, 1996, do hereby certify that under requirements of P.A. 74, Michigan P.A. of 1970, the corner points mentioned in lines 1 and 2 above were in conformance with regulations and rules therefore as required in the current manual of survey instructions of the United States Department of the Interior, Bureau of Land Management or by a decree of a Court of Law and/or that the corner points mentioned in lines 3, 4 and 5 above were in conformance with the rules of the Michigan Board of Professional Surveyors or by a Decree of a Court of Law; established, re-established, monumented, re-monumented, recovered, found as expressed below:

	A	B	C	D	E	F	G	H	I	J	K	L	M
2	5	5	4	3	2	1							
3													
4	7	8	9	10	11	12							
5													
6	18	17	16	15	14	13							
7													
8	19	20	21	22	23	24							
9													
10	30	29	28	27	26	25							
11													
12	31	32	33	34	35	36							
13													

NOTE: Not more than 4 corners, all in the same town and range, may be recorded on this certificate.

A. Description of original monument and accessories and/or subsequent restoration:

- GLO - 1839 L. Clason US GLO 1935 Guy Veal L. 4, P. 341 F. J. King Nov 29, 1988
 Mon. - Post Mon. - Fd. 1/2" iron pipe perpetuated Mon- Fnd. rec. Iron In Mon. Box in center
 WIT: 7" Cedar N53°W 45 lks. original corner replaced with of Pav't (Rec. Bk. 2, Pg. 91)
 14" Cedar N29°E 28 lks. 3 1/2" brass tablet in concrete
 5.61 west of closing corner
- Fargo Engineering 1909 11-25-1961 N.C. Caldwell
 Mon- Iron Bolt 1 3/4" x 16" Mon- Unknown
 buried at corner Wit- Closing corner is East 5.2
 (Indicated found)
- GLO BT's or other good L. 2, P. 91 April 23, 1969
 evidence) Mon- Unknown
 Wit- Closing Corner is East 5.6
 (Closing Corner is U.S.G.L.O. Mon.)

B. Description of corner evidence found and/or method applied in restoring or reestablishing corner:

Found 1/2" bar in pavement box and is accepted as a careful and faithful perpetuation of the position of the original corner. Found closing corner West 5.32 feet.

5/8 corner Sec. 34, T27N, R2E


APPROVED

County Remonumentation
 Peer Review Group

*NCC
 16 NOV 96*

C. Description of monument for corner and accessories established to perpetuate locating the position of the corner:

- Monument - Replaced with Standard Oscoda County Monument in pav't box.
 WIT: Nail NW side utility pole S55°W 48.51'
 Nail NE side utility pole N51°W 80.32'
 Nail N. side utility pole N77°E 116.26'
 Top center concrete project marker N47°E 42.26'

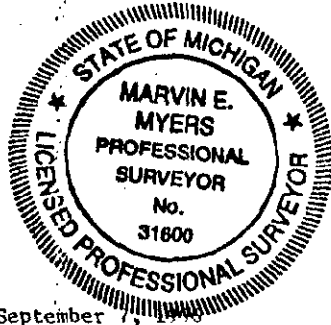

Signed by Marvin E. Myers

Date September 1996

Surveyor's Michigan License No. 31600