

**SURVEY &
REMONUMENTATION**

MAR 19 1997

COMMISSION

**LAND CORNER RECORDATION CERTIFICATE
Filing Requirement of Act 74, Mich. P.A. 1970**

Liber 4 Pg 154

For corners in Oscoda <small>(County)</small>	Located In:	Corner Code #
1. Public Land Survey	T <u>27N</u> R <u>2E</u>	<u>J - 13</u>
	T _____ R _____	_____
	T _____ R _____	_____
	T _____ R _____	_____
2. Property Controlling in Section	S _____ T _____ R _____	_____
	S _____ T _____ R _____	_____
3. Miscellaneous Property in Section	S _____ T _____ R _____	_____
	S _____ T _____ R _____	_____
4. Lot No. _____, Recorded Plat _____		
5. Private Claims _____		

STATE OF MICHIGAN
OSCODA COUNTY
FILED

26 NOV 96 3:10 P.M.

PATSY J. PETERS
REGISTER OF DEEDS

Register of Deeds Stamp & File Number

I, Marvin E. Myers, in a field survey on June 29, 1996, do hereby certify that under requirements of P.A. 74, Michigan P.A. of 1970, the corner points mentioned in lines 1 and 2 above were in conformance with regulations and rules therefore as required in the current manual of survey instructions of the United States Department of the Interior, Bureau of Land Management or by a decree of a Court of Law and/or that the corner points mentioned in lines 3, 4 and 5 above were in conformance with the rules of the Michigan Board of Professional Surveyors or by a Decree of a Court of Law; established, re-established, monumented, re-monumented, recovered, found as expressed below:

NOTE: Not more than 4 corners, all in the same town and range, may be recorded on this certificate.

A. Description of original monument and accessories and/or subsequent restoration:

GLO 1839 L. Clason Mon.-Post WIT: 7" Hemlock N20°W 03 lks. 20" Hemlock N34°E 05 lks.	Notes from Norman Caldwell files Mon.-Fd. Conc. Mon. set ½" bar along side WIT: T.Pole S47°W 48.3' 24" Poplar S39°E 72.4' N½ Cor. Sec. 2 West 5.3'
US GLO 1935 Guy Veal Mon.-Set 3½" Brass Tablet in 6" conc. mon. proportionate distance WIT: 8" Poplar N26½°W 73½ lks. N½ Cor. Sec. 2 is West 0.085 chs.	Liber 3, page 284 July 1981 Norman Caldwell Mon.-Fd. ½" bar in pav't box over US GLO WIT: T.Pole S47°W 48.3' 24" Poplar S29°E 72.4' N½ Cor. Sec. 2 West 5.3'

Liber 4, page 401 Aug. 1989
F. King
Mon.-Fd. 1" bar in mon. box
5.27' E. of N½ Cor. Sec. 2,
T26N, R2E

B. Description of corner evidence found and/or method applied in restoring or reestablishing corner:

Found 1" pipe in pavement box measured 5.3 feet West to closing corner and is accepted as a careful and faithful reestablishment of the position of the original corner.

S½ cor. Section 35, T27N, R2E

APPROVED


County Remonumentation
Peer Review Group

*NCC
16 NOV 96*

C. Description of monument for corner and accessories established to perpetuate locating the position of the corner:

Replaced with a Standard Oscoda County Monument in pav't box.

WIT: Nail NW side 7" Spruce S45°W 63.42'
Fd. spike W. side Power Pole N57°W 90.08'
Fd. spike W. side Light Pole N20°W 30.09'
Fd. spike S. side Power Pole N75°E 95.55'

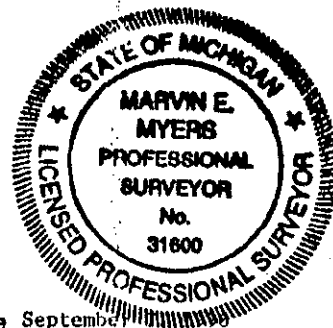

Signed by *Marvin E. Myers*

Date September

Surveyor's Michigan License No. 31600