

**SURVEY &  
REMONUMENTATION**

MAR 19 1997

**COMMISSION**

**LAND CORNER RECORDATION CERTIFICATE  
Filing Requirement of Act 74, Mich. P.A. 1970**

*Liber 4 pg 158*

For corners in <u>Oscoda</u> (County)	Located In:	Corner Code #
1. Public Land Survey	T 27N R 2E T 27N R 3E T _____ R _____ T _____ R _____	M - 2 ✓ A - 2
2. Property Controlling In Section	S _____ T _____ R _____ S _____ T _____ R _____	_____
3. Miscellaneous Property in Section	S _____ T _____ R _____ S _____ T _____ R _____	_____

STATE OF MICHIGAN  
OSCODA COUNTY  
FILED

26 NOV 96 3:14 P.M.

PATSY J. PETERS  
REGISTER OF DEEDS

Register of Deeds Stamp & File Number

4. Lot No. \_\_\_\_\_, Recorded Plat \_\_\_\_\_  
5. Private Claims \_\_\_\_\_

A	B	C	D	E	F	G	H	I	J	K	L	M
2	6	5	4	3	2	1						
3												
4	7	8	9	10	11	12						
5												
6	18	17	16	15	14	13						
7												
8	19	20	21	22	23	24						
9												
10	30	29	28	27	26	25						
11												
12	31	32	33	34	35	36						
13												

I, Marvin E. Myers, in a field survey on June 28, 1996, do hereby certify that under requirements of P.A. 74, Michigan P.A. of 1970, the corner points mentioned in lines 1 and 2 above were in conformance with regulations and rules therefore as required in the current manual of survey instructions of the United States Department of the Interior, Bureau of Land Management or by a decree of a Court of Law and/or that the corner points mentioned in lines 3, 4 and 5 above were in conformance with the rules of the Michigan Board of Professional Surveyors or by a Decree of a Court of Law; established, re-established, monumented, re-monumented, recovered, found as expressed below:

**NOTE: Not more than 4 corners, all in the same town and range, may be recorded on this certificate.**

**A. Description of original monument and accessories and/or subsequent restoration:**

GLO Lewis Glason May 1839 Mon.-(A)Set Post WIT: (1) 16" dry Pine stub S59½°W 25 lks. (2)24" dry Pine stub N75°W 43 lks.	Norm Caldwell Date Unknown Mon.-(C)DNR Mon. Larry Beauregard Sept. 28, 1992 Liber 192, page 5140 Mon.-(D)Oscoda Std. Co. Cor.	Norman Quaine Feb. 2, 1994 LCRC Liber 3, page 252 Mon.-(E)DNR Dept. Mon. WIT: 5" W.Pine N62°E 13.35' 14" Aspen S59°E 37.30' 10" W.Pine S21°E 41.32' 6" R.Pine S88°W 49.84'
K. Ostling Nov. 1968 Mon.-(B)Set DNR mon. by single proportion		

**B. Description of corner evidence found and/or method applied in restoring or reestablishing corner:**


Found Oscoda County Monument  
And is accepted as a careful and faithful reestablishment of the position of the original corner  
½ Corner common to Section 1, T27N, R2E and Section 6, T27N, R3E

**APPROVED**  
County Remonumentation  
Peer Review Group

*NCC  
16 NOV 96*

**C. Description of monument for corner and accessories established to perpetuate locating the position of the corner:**

Found record standard Oscoda County Monument  
WIT: Fd. nail & tag S. side 5" W.Pine N62°E 13.35' (R)  
Fd. nail & tag N. side 6" R.Pine S88°W 49.84' (R)  
Fd. nail & tag S. side 14" Aspen S59°E 37.30' (R)  
Fd. nail & tag 10" W.Pine S21°E 41/32'

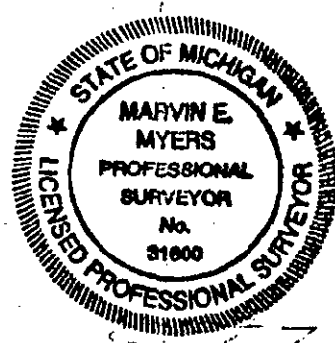

Signed by Marvin E. Myers

Date 11/25/96

Surveyor's Michigan License No. 31600