

**SURVEY &  
REMONUMENTATION**

MAR 19 1997

COMMISSION

**LAND CORNER RECORDATION CERTIFICATE  
Filing Requirement of Act 74, Mich. P.A. 1970**

*Liber 4 Pg 167*

For corners in <u>Oscoda</u> <small>(County)</small>	Located in:	Corner Code #
1. Public Land Survey	T 27N R 2E T 27N R 3E T _____ R _____ T _____ R _____	<u>M - 11</u> <u>A - 11</u>
2. Property Controlling in Section	S _____ T _____ R _____ S _____ T _____ R _____	_____
3. Miscellaneous Property in Section	S _____ T _____ R _____ S _____ T _____ R _____	_____
4. Lot No. _____, Recorded Plat _____		
5. Private Claims _____		

STATE OF MICHIGAN  
OSCODA COUNTY  
FILED

26 NOV 96 3:23 P.M.

PATSY J. PETERS  
REGISTER OF DEEDS

Register of Deeds Stamp & File Number

A	B	C	D	E	F	G	H	I	J	K	L	M
2	6	5	4	3	2	1						
3												
4	7	8	9	10	11	12						
5												
6	18	17	16	15	14	13						
7												
8	19	20	21	22	23	24						
9												
10	30	29	28	27	26	25						
11												
12	31	32	33	34	35	36						
13												

I, Marvin E. Myers, in a field survey on June 28, 19 96, do hereby certify that under requirements of P.A. 74, Michigan P.A. of 1970, the corner points mentioned in lines 1 and 2 above were in conformance with regulations and rules therefore as required in the current manual of survey instructions of the United States Department of the Interior, Bureau of Land Management or by a decree of a Court of Law and/or that the corner points mentioned in lines 3, 4 and 5 above were in conformance with the rules of the Michigan Board of Professional Surveyors or by a Decree of a Court of Law; established, re-established, monumented, re-monumented, recovered, found as expressed below:

**NOTE: Not more than 4 corners, all in the same town and range, may be recorded on this certificate.**

**A. Description of original monument and accessories and/or subsequent restoration:**

- |   |   |   |
|---|---|---|
| GLO Lewis Clason May 1839<br>Mon.-(A)Set post<br>WIT: (1)9" W.Pine S46½°W 19 lks.<br>(2)10" Aspen N45½°W 18 lks.  | Norm Caldwell Mar. 21, 1968<br>Mon.-None given<br>WIT: (6)C M-33 West 7.8'<br>Norm Caldwell Date Unknown<br>Mon.-(C)          | Clifford Lindgren Oct. 3, 1988<br>LCRC Liber 3, page 40<br>Mon.-(E)Fd. boatspike inside 4" dia. iron pipe in mon. box<br>(F)Set ½" rod with cap "MDOT 14098) in mon. box<br>WIT: (6)& on C of Kittle Road E-W<br>(7)Fd. chisled "X" in N. end of conc. Hdwl. N35°W 76.48'<br>(8)G.Pole N50°W 104.81'<br>(9)G.Pole S50°E 94.58'<br>(10)Chisled "X" in S. end of conc. Hdwl. N42°E 62.61' |
| George Henning Date Unknown<br>County Surveyor Book 3, page 194<br>Mon.-(B)Fd. Seeley's cor.<br>WIT: (3)Fd. Seeley's fence post<br>(4)C M-33 & County Rd. 489 | Norm Caldwell June 21, 1972<br>Liber 1, page 216<br>Mon.-None given<br>WIT: (6)   | Larry Beauregard Aug. 17, 1990 Liber 4, page 462<br>Mon.-(G)½" bar in mon. box<br>WIT: (5)Fd.   |
| George Henning Sept. 1958<br>Mon.-(C)Iron mon. box<br>WIT: (5)C M-33 West 7.5'  | Norm Caldwell Jan. 30, 1979<br>Liber 3, page 46 also<br>LCRC Liber 1, page 224<br>Mon.-(D)Fd. iron in mon. box<br>WIT: (5)Fd. | Larry Beauregard Oct. 27, 1992 Liber 192, page 6098<br>Mon.-(G)<br>WIT: (6)Fd.  |
| Norm Caldwell Date Unknown<br>Mon.-(C)<br>WIT: (5)  | Frederick King Oct. 8, 1987<br>Liber 4, page 205<br>Mon.-(D)<br>WIT: (5)Fd.   |   |

**B. Description of corner evidence found and/or method applied in restoring or reestablishing corner:**

Found ½" bar & cap  
And is accepted as a careful and faithful reestablishment of the position of the original corner  
Corner common to T27N, R2 & 3E


**C. Description of monument for corner and accessories established to perpetuate locating the position of the corner:**

Placed standard Oscoda County cap on 5/8" bar in pav't box, 7.8' East of C M-33 & 72  
WIT: Found (7)  
Found (8) Set nail & tag S. side  
Found (10)  
Found (9) MDOT nail & tag N. side

**APPROVED**

County Remonumentation  
Peer Review Group

*McC  
16 Nov 96*

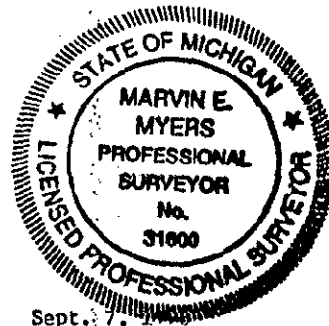

Signed by *Marvin E. Myers*

Date Sept. 7, 1996

Surveyor's Michigan License No. 31600