

**SURVEY & MONUMENTATION**

MAR 19 1997

**COMMISSION**

**LAND CORNER RECORDATION CERTIFICATE**  
Filing Requirement of Act 74, Mich. P.A. 1970

*Liber 4 Pg 169*

For corners in Oscoda (County)	Located In:	Corner Code #
1. Public Land Survey	T 27N R 2E	M - 13 ✓
	T 27N R 3E	A - 13
	T 26N R 3E	A - 1
	T 26N R 2E	M - 1
2. Property Controlling in Section	S T R	
	S T R	
3. Miscellaneous Property in Section	S T R	
	S T R	
4. Lot No. _____, Recorded Plat		
5. Private Claims		

STATE OF MICHIGAN  
OSCODA COUNTY  
FILED

26 NOV 96 3:25 P.M.

PATSY J. PETERS  
REGISTER OF DEEDS

Register of Deeds Stamp & File Number

A	B	C	D	E	F	G	H	I	J	K	L	M
2	6	5	4	3	2	1						
3												
4	7	8	9	10	11	12						
5												
6	18	17	16	15	14	13						
7												
8	19	20	21	22	23	24						
9												
10	30	29	28	27	26	25						
11												
12	31	32	33	34	35	36						
13												

I, Marvin E. Myers, in a field survey on June 28, 1996, do hereby certify that under requirements of P.A. 74, Michigan P.A. of 1970, the corner points mentioned in lines 1 and 2 above were in conformance with regulations and rules therefore as required in the current manual of survey instructions of the United States Department of the Interior, Bureau of Land Management or by a decree of a Court of Law and/or that the corner points mentioned in lines 3, 4 and 5 above were in conformance with the rules of the Michigan Board of Professional Surveyors or by a Decree of a Court of Law; established, re-established, monumented, re-monumented, recovered, found as expressed below:

**NOTE: Not more than 4 corners, all in the same town and range, may be recorded on this certificate.**

**A. Description of original monument and accessories and/or subsequent restoration:**

GLO - Lewis Clawson May 1839  
(A) Mon.-Set Post  
WIT: (1) 30" Y. Pine S41½°W 175 lks.  
(2) 36" W. Pine N41°E 105 lks.

C.O. Seeley 1912±  
(B) Mon.-Set 2"x18" iron pipe from remains of original BTS

F.S. Houghton Sept. 14, 1916  
(County Surveyor Book 2, pg. 144)  
(C) Mon.-1½" pipe at cor.

Guy R. Veal Sept. 17, 1930  
(Dependent survey)  
Mon.-Fd. (B)

(D) Set conc. mon. 36" long, 8"x11" at base, 8"x8" at top, reinforced by std. iron cor. post 36" long x 1" dia. with marked brass cap  
WIT: Fd. remains (2)

(3) Fd. BT marked by local surveyor  
(4) Fd. 12" B.Oak marked "NBT" S36°E 158 lks.

(5) 6" N.Pine marked "T27N R3E S31 BT" N61½°E 102½ lks.

(6) 10" J.Pine marked "T26N R3E S6 BT" S75½°E 118 lks.

(7) 12" B.Oak marked "T26N R2E S1 BT" S41½°W 217 lks.

(8) 7" B.Oak marked "T27N R2E S36 BT" N38½°W 208 lks.

Guy R. Veal Oct. 2, 1935  
Mon.-Fd. (D)

George Henning Date Unknown  
(County Surveyor Book 3, page 50)  
Mon.-Fd. (D)

WIT: Fd. (6) S74°45'E 77.40'  
Fd. (7) S41°30'W 142.8'

George Henning Date Unknown  
(County Surveyor Book 3, page 194)  
Mon.-Fd. (D)

WIT: Fd. (8) 6" Tw.Oak N47°45'W 137.3'  
Fd. (5) N62°E 67.5'

George Henning Date Unknown  
Mon(C)-Iron pin over US Mon. under road

George Henning Sept. 5, 1958  
Mon.(F)-Iron mon. box over US cor. in centerline M-33

S. Ernest Lucas June 30, 1959  
Mon.(G)-Fd. Cabin spike in mon. box

Norman Caldwell Feb. 1965  
Mon.(H)-Centerline P.I.

Norman Caldwell April 23, 1969  
LCRC Liber 2, page 85  
Mon.-Fd. (G)

Norman Caldwell Aug. 1982  
LCRC Liber 1, page 35  
Mon.-Fd. (G) at intersection of Cherry Creek Road E&W & M33 - M72 N&S


Larry Beauregard Sept. 29, 1982  
Liber 3, page 355  
Mon.-(H) Fd. ½" bar & cap

Clifford Lindgren Oct. 13, 1988  
LCRC Liber 3, page 36  
Mon.-Fd.(H) in mon. box 1' East of M-72 Q & on Q Cherry Creek Rd. West  
(I) Set ½" rerod & cap "MDOT #14098" in mon. box

WIT: (9) T.Pole S25°W 67.36'  
(10) T.Pole N15°W 101.13'  
(11) P.Pole N70°E 57.30'  
(12) T.Pole S65°E 73.28'

**APPROVED**  
County Remonumentation  
Peer Review Group

*REC  
16 NOV 96*

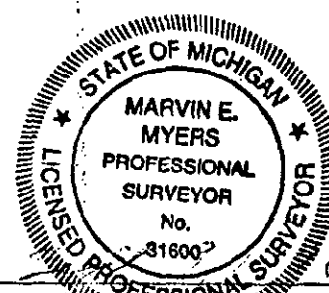

Signed by Marvin E. Myers  
Surveyor's Michigan License No. 31600

Date \_\_\_\_\_