

MICHIGAN
DEPARTMENT OF CONSERVATION
FORESTRY DIVISION

LAND CORNER RECORD

T. 27 N.R. 3 E


Oscoda COUNTY

DESCRIPTION OF CORNER 1/4 corner common to Section 6-7

CORNER MONUMENT Set Dept. Monument

DATE MONUMENT PLACED AND WITNESSED 10-24-68

WITNESSES TO CORNER.....

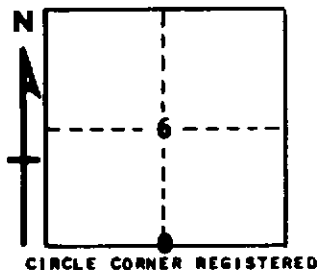

14" R. Pine N 56 E 114.8'

3" R. Pine N 45 W 54.5'

AND

DESCRIPTION IN DETAIL AS TO HOW CORNER WAS LOCATED AND IDENTIFIED OR RESTORED.

This corner was established by proportionate measurement between section corners.
Unable to locate anything definite for a previous corner.

SURVEYOR'S SEAL

SIGNED *Kenneth W. Utting* DATE 11/27/68
REGISTERED LAND SURVEYOR #10068