

LAND CORNER RECORDATION CERTIFICATE

FILING REQUIREMENT OF ACT 74, MICH. P.A.1970

FOR CORNERS OF--:	LOCATED IN--:	CORNER CODE NUMBER
1. PUBLIC LAND SURVEY-----	T. <u>27</u> N. S. R. <u>3</u> E. W.	G-7; H-7; I-7; J-7.
2. PROPERTY CONTROLLING IN SECTION-----	T.----- N. S. R.----- E. W.	
3. MISCELLANEOUS PROPERTY IN SECTION-----	T.----- N. S. R.----- E. W.	
4. LOT NO.-----, RECORDED PLAT-----		
5. PRIVATE CLAIMS-----		

REGISTER OF DEEDS STAMP AND FILING NUMBER

I, Kenneth J. Ostling, do hereby certify that under requirements of P.A. 74, Michigan P.A. of 1970, the corner points mentioned in lines 1 and 2 above were, in a field survey on January 25, 1980, established, re-established, monumented, re-monumented, recovered or restored as expressed below and in conformance with regulations and rules therefore as required in the current manual of survey instructions of the United States Department of the Interior, Bureau of Land Management or by a decree of a court of law. Furthermore, that the corner points mentioned in lines 3, 4 and 5 above were, in a field survey on _____, 19____, found, recovered, restored, established or re-established as expressed below and in conformance with the rules of the Michigan State Board of Registration for Land Surveyors or, by a Decree of a Court of law:

~~A. Description of monument for corner and accessories established to perpetuate locating the position of the corner:~~

B. Continued
 also fits for line to corner east and west. Park brass monument northwesterly was disregarded at this location also.

J-7 Found pipe as restored in 1934 survey by Marcus Schaaf.

B. Description of corner evidence found and/or method applied in restoring or re-establishing corner:

G-7 Found 1 1/2" pipe as restored by Marcus Schaaf in 1934, and used in subsequent adjacent surveys.

H-7 Found corner as restored in 1934 survey by Marcus Schaaf from USBT stump. Recovered and witnessed in 1956 survey by this Department.


I-7 Found 1 1/2' pipe with conc. base at corner as established in 1934 survey by Marcus Schaaf His record claims corner was set by reference to the original gov't corner location where the "old" witnesses were identified. Believe this position has best U.S. evidence and

C. Description of monument for corner and accessories established to perpetuate locating the position of the corner:

<p>G-7 Replaced 1 1/2" pipe with DNR Mon. 18" W. Pine S53°E 23.3' 4" Spruce N 70°E 20.4' Trail Road North - 34'</p>	<p>H-7 5" W. Pine N47°E 9.2' 3" R. Pine S50°E 15.9' Set Red top post J-7 Fd 1 1/2" pipe - Set DNR Mon Red top Post 4" J. Pine S34°E 16.2' 4" J. Pine N55°E 7.4' EW trail rd North-18'</p>	<p>I-7 Mon Fd 1 1/2" pipe in conc. set DNR Nail & ref tag S75°W 144.65 Nail & ref tag in 12" TW RP N48°W 146.48' Set Cedar Po</p>
---	---	---

SIGNED BY Kenneth J. Ostling

DATE 10/20/80

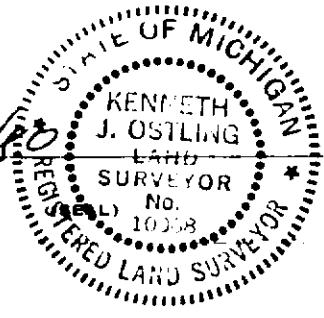

SURVEYOR'S MICHIGAN REGISTRATION NO. _____

FOR STATE AND UNITED STATES AGENCIES:

SIGNED BY _____ DATE _____
CHIEF OF SURVEY PARTY

APPROVED AND SIGNED BY _____ DATE _____
MICHIGAN REGISTERED LAND SURVEYOR

(SEAL)

SURVEYOR'S MICHIGAN REGISTRATION NO. _____

Oscoda