

SURVEY & REMONUMENTATION

MAR 19 1997

COMMISSION

LAND CORNER RECORDATION CERTIFICATE
Filing Requirement of Act 74, Mich. P.A. 1970

For corners in Oscoda (County) Located in: Corner Code #

1. Public Land Survey

T	<u>27N</u>	R	<u>2E</u>	M - 4
T	<u>27N</u>	R	<u>3E</u>	A - 4 ✓
T	_____	R	_____	_____
T	_____	R	_____	_____
2. Property Controlling in Section

S	_____	T	_____	_____
S	_____	T	_____	_____
3. Miscellaneous Property in Section

S	_____	T	_____	_____
S	_____	T	_____	_____
4. Lot No. _____, Recorded Plat _____
5. Private Claims _____

Liber 4 Pg 160

STATE OF MICHIGAN
 OSCODA COUNTY
 FILED
 26 NOV 96 3:16 P.M.

PATSY J. PETERS
 REGISTER OF DEEDS
 Register of Deeds Stamp & File Number

	A	B	C	D	E	F	G	H	I	J	K	L	M
2	6	5	4	3	2	1							
3													
4	7	8	9	10	11	12							
5													
6	18	17	16	15	14	13							
7													
8	19	20	21	22	23	24							
9													
10	30	29	28	27	26	25							
11													
12	31	32	33	34	35	36							
13													

I, Marvin E. Myers, in a field survey on June 28, 1996, do hereby certify that under requirements of P.A. 74, Michigan P.A. of 1970, the corner points mentioned in lines 1 and 2 above were in conformance with regulations and rules therefore as required in the current manual of survey instructions of the United States Department of the Interior, Bureau of Land Management or by a decree of a Court of Law and/or that the corner points mentioned in lines 3, 4 and 5 above were in conformance with the rules of the Michigan Board of Professional Surveyors or by a Decree of a Court of Law; established, re-established, monumented, re-monumented, recovered, found as expressed below:

NOTE: Not more than 4 corners, all in the same town and range, may be recorded on this certificate.

A. Description of original monument and accessories and/or subsequent restoration:

- | | | |
|--|--|--|
| GLO Lewis Clason May 1839
Mon.-(A)Set post
WIT: (1)8" Maple S47°W 67 lks.
(2)24" Beech N68½°W 34 lks. | Larry Beauregard Sept. 28, 1992
Liber 192, page 5140
Mon.-(B) | Larry Beauregard June 6, 1994
Liber 194, page 3854
Mon.-(B)
WIT: (3)6" Maple N10°E 8.94'
(4)12" Maple S85°W 22.06'
(5)15" Maple S10°E 23.96'
(6)10" Maple S45°E 21.40' |
| Carl Johnson June 5, 1985
Mon.-(B) | Frederick King June 13, 1988
Liber 4, page 306
Mon.-(B)Fd. Std. Co. Cor. | |

B. Description of corner evidence found and/or method applied in restoring or reestablishing corner:


Monument - Found Standard Oscoda County Monument
 Found (3)
 Found (6)
 Found (5)
 Found (4)
 Found (5)
 A careful and faithful establishment of the position of the Corner.
 ½ Corner common to Section 12, T27N, R2E and Section 7, T27N, R3E

APPROVED
 County Remonumentation
 Peer Review Group

*NCC
 16 NOV 96*

C. Description of monument for corner and accessories established to perpetuate locating the position of the corner:

Found Standard Oscoda County Monument
 WIT: Fd. spike W. side 6" Maple N23°E 8.94'
 Set nail NE side 6" Beech S42°E 27.83'
 Fd. nail W. side 15" Maple (blaze on face) S07°E 24.05'
 Set nail S. side 13" Maple N62°W 13.16'

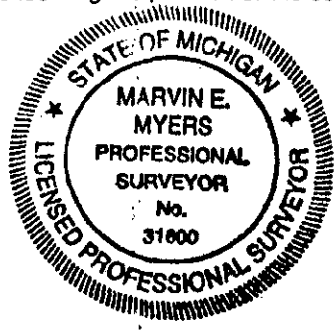

Signed by Marvin E. Myers
 Surveyor's Michigan License No. 31600

Date Sept 7, 1996