

**SURVEY &
REMONUMENTATION**

MAR 19 1997

COMMISSION

**LAND CORNER RECORDATION CERTIFICATE
Filing Requirement of Act 74, Mich. P.A. 1970**

Liber 4 Pg 167

For corners in Oscoda (County) Located in: _____ Corner Code # _____

1. Public Land Survey	T	27N	R	2E	M - 11
	T	27N	R	3E	<u>A - 11</u> ✓
	T		R		
	T		R		
2. Property Controlling in Section	S		T	R	
	S		T	R	
3. Miscellaneous Property in Section	S		T	R	
	S		T	R	

4. Lot No. _____, Recorded Plat _____
5. Private Claims _____

STATE OF MICHIGAN
OSCODA COUNTY
FILED

26 NOV 96 3:23 P.M.

PATSY J. PETERS
REGISTER OF DEEDS

Register of Deeds Stamp & File Number

I, Marvin E. Myers, in a field survey on June 28, 19 96
do hereby certify that under requirements of P.A. 74, Michigan P.A. of 1970, the corner points mentioned in lines 1 and 2 above were in conformance with regulations and rules therefore as required in the current manual of survey instructions of the United States Department of the Interior, Bureau of Land Management or by a decree of a Court of Law and/or that the corner points mentioned in lines 3, 4 and 5 above were in conformance with the rules of the Michigan Board of Professional Surveyors or by a Decree of a Court of Law; established, re-established, monumented, re-monumented, recovered, found as expressed below:

NOTE: Not more than 4 corners, all in the same town and range, may be recorded on this certificate.

A	B	C	D	E	F	G	H	I	J	K	L	M
2	6	5	4	3	2							
3												
4	7	8	9	10	11	12						
5												
6	18	17	16	15	14	13						
7												
8	19	20	21	22	23	24						
9												
10	30	29	28	27	26	25						
11												
12	31	32	33	34	35	36						
13												

A. Description of original monument and accessories and/or subsequent restoration:

- | | | |
|---|---|---|
| GLO Lewis Clason May 1839
Mon.-(A)Set post
WIT: (1)9" W.Pine S46½°W 19 lks.
(2)10" Aspen N45½°W 18 lks. | Norm Caldwell Mar. 21, 1968
Mon.-None given
WIT: (6)C M-33 West 7.8' | Clifford Lindgren Oct. 3, 1988
LCRC Liber 3, page 40
Mon.-(E)Fd. boatspike inside 4" dia. iron pipe in mon. box
(F)Set ½" rerod with cap "MDOT 14098" in mon. box
WIT: (6)& on C of Kittle Road E-W
(7)Fd. chisled "X" in N. end of conc. Hdwl. N35°W 76.48'
(8)G.Pole N50°W 104.81'
(9)G.Pole S50°E 94.58'
(10)Chisled "X" in S. end of conc. Hdwl. N42°E 62.61' |
| George Henning Date Unknown
County Surveyor Book 3, page 194
Mon.-(B)Fd. Seeley's cor.
WIT: (3)Fd. Seeley's fence post
(4)C M-33 & County Rd. 489 | Norm Caldwell June 21, 1972
Liber 1, page 216
Mon.-None given
WIT: (6) | Larry Beauregard Aug. 17, 1990 Liber 4, page 462
Mon.-(G)½" bar in mon. box
WIT: (5)Fd. |
| George Henning Sept. 1958
Mon.-(C)Iron mon. box
WIT: (5)C M-33 West 7.5' | Norm Caldwell Jan. 30, 1979
Liber 3, page 46 also
LCRC Liber 1, page 224
Mon.-(D)Fd. iron in mon. box
WIT: (5)Fd. | Larry Beauregard Oct. 27, 1992 Liber 192, page 6098
Mon.-(G)
WIT: (6)Fd. |
| Norm Caldwell Date Unknown
Mon.-(G)
WIT: (5) | Frederick King Oct. 8, 1987
Liber 4, page 205
Mon.-(D)
WIT: (5)Fd. | |

B. Description of corner evidence found and/or method applied in restoring or reestablishing corner:

Found ½" bar & cap
And is accepted as a careful and faithful reestablishment of the position of the original corner
Corner common to T27N, R2 & 3E


C. Description of monument for corner and accessories established to perpetuate locating the position of the corner:

Placed standard Oscoda County cap on 5/8" bar in pav't box, 7.8' East of C M-33 & 72
WIT: Found (7)
Found (8) Set nail & tag S. side
Found (10)
Found (9) MDOT nail & tag N. side

APPROVED

County Remonumentation
Peer Review Group

*REC
16 NOV 96*

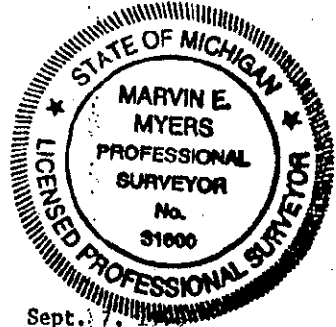

Signed by Marvin E. Myers

Date Sept. 7, 1996

Surveyor's Michigan License No. 31600