

SURVEY & REMONUMENTATION

OCT 08 1997

COMMISSION

LAND CORNER RECORDATION CERTIFICATE
Filing Requirement of Act 74, Mich. P.A. 1970

Liber 4 Page 185

For corners in

<u>Oscoda</u> (County)	Located In:	Corner Code #
1. Public Land Survey	T27N R 3E	C-12
	T ___ R ___	_____
	T ___ R ___	_____
	T ___ R ___	_____
2. Property Controlling in Section	S ___ T ___ R ___	_____
	S ___ T ___ R ___	_____
3. Miscellaneous Property in Sec.	S ___ T ___ R ___	_____
	S ___ T ___ R ___	_____

STATE OF MICHIGAN
OSCODA COUNTY
FILED

29 AUG 97 9:12 A.M.

PATSY J. PETERS
REGISTER OF DEEDS

Register of Deeds Stamp & File Number

4. Lot No. _____, Recorded Plat _____
5. Private Claims _____

I, Marvin E. Myers, P.S., in a field survey on June 25, 1997 do hereby state that under requirements of P.A. 74, Michigan P.A. of 1970, the corner points mentioned in lines 1 and 2 above were in conformance with regulations and rules therefore as required in the current manual of survey instructions of the United States Department of the Interior, Bureau of Land Management or by a decree of a Court of Law and for that the corner points mentioned in lines 3, 4 and 5 above were in conformance with the rules of the Michigan Board of Land Surveyors or by a Decree of a Court of Law; established, re-established, monumented, recovered, found as expressed below:

NOTE: Not more than 2 corners, all in the same town and range, may be recorded on this certificate.

A	B	C	D	E	F	G	H	I	J	K	L	M
1												
2	6		5		4		3		2		1	
3												
4	7		8		9		10		11		12	
5												
6	18		17		16		15		14		13	
7												
8	19		20		21		22		23		24	
9												
10	30		29		28		27		26		25	
11												
12	31		32		33		34		35		36	

A. Description of original monument and accessories and/or subsequent restoration:

GLO - Oct 1839, L. Clason, D.S. Mon - Post Wit: 10" Fir S11°E 12 Lks 4" Aspen N9°W 10 Lks	Sept 1958 G. Henning, P.S. #2240 Mon - Found Seeley's 2" Pipe Wit: Found Seeley's pipe in Concrete monument N49°W 25.7 8" B Oak S27°W 42.8 10" Aspen S48°E 46.4
--	---

Sept 26, 1888 J. Randall, Co. Surveyor Mon - Set Post single proportion. Wit: None given	LCRC L.2, P.3764 N. Caldwell, P.S. #12018 Jan, 15, 1971 Mon: Found 2" Pipe replaced with Standard Co. Marker Wit: Pipe in Concrete N49°W 25.7 8" Oak S27°W 42.8 10" Polar S48°E 46.4
--	--

Sept 19, 1916 C. O. Seeley, Co. Surveyor
Mon - Set 2"x3.8" Iron tube
Wit: Concrete Wit N50°W 39 Lks

APPROVED

County Remonumentation
Peer Review Group


NCC/12 AUG 97

B. Description of corner evidence found and/or method applied in restoring or reestablishing corner:

Found Standard Oscoda Co. Mon. Left 2"x58" Iron pipe N85°E 0.50 in place for reference and evidence. Found spike in E. Face 16" B. Oak S30°W 43.16; found spike in NE face 12" poplar S43°E 46.78; Monument is in line with fences E-W & N. Accepted Standard Oscoda County Monument as the best available evidence of the position of the Original Corner.

C. Description of monument for corner and accessories established to perpetuate locating the position of the corner:

1/2 corner common to Sections 31, & 32 T27N, R3E
Mon- Standard Oscoda County Monument
Wit: Spike in E. Side of 16" B. Oak S30°E 43.14
Spike in SW side 4" Poplar S53°E 14.81
Spike in S. Side 6" Spruce N72°W 9.56
Spike in S. Side 4" J. pine N31°E 46.32

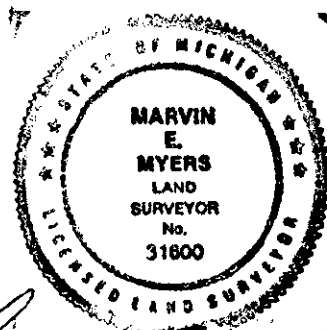

Signed by *Marvin E. Myers*
Surveyor's Michigan License No. 31600

Date *July 31, 1997*