

**SURVEY & REMONUMENTATION**

OCT 08 1997

COMMISSION

**LAND CORNER RECORDATION CERTIFICATE**  
 Filing Requirement of Act 74, Mich. P.A. 1970

*Liber 4 Page 180*

For corners in

<u>Oscoda</u> (County)	Located In:	Corner Code #
1. Public Land Survey	T27N R 3E	I-11
	T R	
	T R	
	T R	
2. Property Controlling in Section	S T R	
	S T R	
3. Miscellaneous Property in Sec.	S T R	
	S T R	

STATE OF MICHIGAN  
 OSCODA COUNTY  
 FILED

29 AUG 97 9:07 A.M.

PATSY J. PETERS  
 REGISTER OF DEEDS

Register of Deeds Stamp & File Number

4. Lot No. \_\_\_\_\_, Recorded Plat \_\_\_\_\_  
 5. Private Claims \_\_\_\_\_

I, Marvin E. Myers, P.S., in a field survey on June 24, 19 97 do hereby state that under requirements of P.A. 74, Michigan P.A. of 1970, the corner points mentioned in lines 1 and 2 above were in conformance with regulations and rules therefore as required in the current manual of survey instructions of the United States Department of the Interior, Bureau of Land Management or by a decree of a Court of Law and /or that the corner points mentioned in lines 3, 4 and 5 above were in conformance with the rules of the Michigan Board of Land Surveyors or by a Decree of a Court of Law; established, re-established, monumented, recovered, found as expressed below:

**NOTE: Not more than 2 corners, all in the same town and range, may be recorded on this certificate.**

	A	B	C	D	E	F	G	H	I	J	K	L	M
1													
2	6		5		4		3		2		1		
3													
4	7		8		9		10		11		12		
5													
6	18		17		16		15		14		13		
7													
8	19		20		21		22		23		24		
9													
10	30		29		28		27		26		25		
11													
12	31		32		33		34		35		36		

A. Description of original monument and accessories and/or subsequent restoration:

GLO -Oct 1839 L. Clason, D.S.

July 15, 1885 J. Randall Co. Surveyor  
 (Observed a false corner

Mon- Post

Wit: 14" Hemlock S30°E 17 Lks  
 10" Birch N37°E 56 Lks

running a random N03°E 83.7 Chains from I-13.

False corner was 10 Lks East with the following trees not of record 20" W. Pine N69½°E 53 Lks; 10" Birch; Aspen N W; W. Pine S. These were faced with blaze about breast high and apparent to been accepted as Section corner, but trees have no chain = notch nor foot work and were not marked.)

Mon- Set Post

Wit: 36" W. Pine N84½°E 50 Lks  
 8" Cedar N12½°W 32½ Lks

Oct 1962 N. C. Caldwell, P.S. #12018

Mon - Set by Proportion

Wit: None given

L4, P.408 L. Beauregard, P.S. #18654

Mon - Existing Bar & Cap in Centerline of Abbe Road in Mon. Box

Wit: P. Pole S57°E 62.0

B. Description of corner evidence found and/or method applied in restoring or reestablishing corner:

Found ½" bar & cap #12018 in Monument box in centerline of N-S Road; found P.Pole S57°E 62.0 Accepted ½" bar & cap as a careful and faithful establishment of the position of the corner. Replaced ½" bar with 5/8"x30" rebar and Standard Oscoda County Cap.

**APPROVED**

County Remonumentation


Review Group  
*NIC / 12 AUG 97*

C. Description of monument for corner and accessories established to perpetuate locating the position of the corner.

Section corner common to Sections 26, 27, 34, & 35

Mon - Standard Oscoda County Monument in existing monument box in centerline of N-S paved road:

Wit: Nail & tag in NE side 4" Poplar S55°W 38.34  
 Nail & tag in N. side 3" Cedar N54°W 55.84  
 Nail & tag in N. side 8" Poplar N82°E 80.40  
 Nail & tag in N. side Power Pole S55°E 62.0

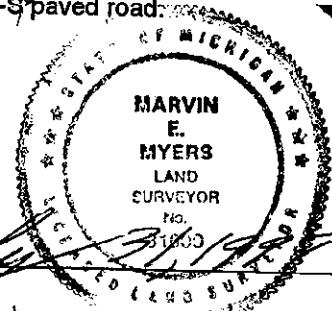

Signed by *Marvin E. Myers*  
 Surveyor's Michigan License No. 31600

Date *July 31 1997*