

OCT 08 1997

COMMISSION

LAND CORNER RECORDATION CERTIFICATE
Filing Requirement of Act 74, Mich. P.A. 1970

Liber 4 Page 188

For corners in

Oscoda (County)	Located In:	Corner Code #
1. Public Land Survey	T27N R3E	I-12
	T___ R___	_____
	T___ R___	_____
	T___ R___	_____
2. Property Controlling in Section	S___ T___ R___	_____
	S___ T___ R___	_____
3. Miscellaneous Property in Sec.	S___ T___ R___	_____
	S___ T___ R___	_____

STATE OF MICHIGAN
OSCODA COUNTY
FILED

29 AUG 97 9:15 A.M.

PATSY J. PETERS
REGISTER OF DEEDS

Register of Deeds Stamp & File Number

4. Lot No. _____, Recorded Plat _____
5. Private Claims _____

I, Marvin E. Myers, P.S., in a field survey on June 24, 1997, do hereby state that under requirements of P.A. 74, Michigan P.A. of 1970, the corner points mentioned in lines 1 and 2 above were in conformance with regulations and rules therefore as required in the current manual of survey instructions of the United States Department of the Interior, Bureau of Land Management or by a decree of a Court of Law and for that the corner points mentioned in lines 3, 4 and 5 above were in conformance with the rules of the Michigan Board of Land Surveyors or by a Decree of a Court of Law, established, re-established, monumented, recovered, found as expressed below:

NOTE: Not more than 2 corners, all in the same town and range, may be recorded on this certificate.

	A	B	C	D	E	F	G	H	I	J	K	L	M
1													
2	6		5		4		3		2		1		
3													
4	7		8		9		10		11		12		
5													
6	18		17		16		15		14		13		
7													
8	19		20		21		22		23		24		
9													
10	30		29		28		27		26		25		
11													
12	31		32		33		34		35		36		

A. Description of original monument and accessories and/or subsequent restoration:

GLO - Oct 1839 L. Clason, D.S.

Mon - Post

Wit: 6" Spruce Pine N73°E 40 Lks

7" Spruce Pine S70½°W 22 Lks

Oct 1962 N. Caldwell, P.S. #12018

Mon - Set RR Spike by single proportion

Wit: 3/4" Pipe East 33.00

July 15, 1885 J. Randall, Co. Surveyor

Mon - Set Post

Wit: 7" W. Oak N51°W 97 Lks.

8" Y. Pine S48°E 64 Lks

LCRC L. 1, P. 228 N. Caldwell, P.S. #12018 July 20, 1979

Mon - Found bar and cap established by single proportion

Wit: ½" bar East 33.00

Concrete Mon. East 65.0

B. Description of corner evidence found and/or method applied in restoring or reestablishing corner:

Found 1/2" bar and cap in monument box in centerline of N-S road in line with fence going East; found 3/4" pipe East 33.00; found concrete monument East 65.0
Accepted ½" bar as a careful and faithful establishment of the position of the corner. Replaced ½" bar with 5/8"x30" rebar and Standard Oscoda County Cap.

APPROVED

County Remonumentation
Peer Review Group

NCC/12 AUG 97

C. Description of monument for corner and accessories established to perpetuate locating the position of the corner:

¼ corner common to Sections 34 & 35, T27N, R3E

Mon - Standard Oscoda County Monument in existing monument box in centerline of N-S paved road.

Wit: 12" W. Pine S56°E 73.31


Power Pole N86°E 43.42

Found Concrete Monument East 65.00

Found 3/4" Pipe East 33.00

8" Poplar N56°W 38.45

10" R. Oak S64°W 48.90

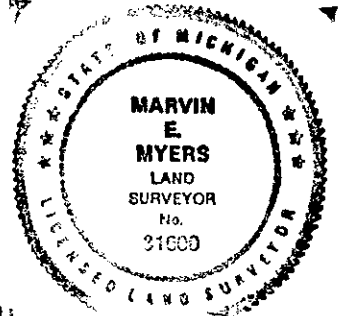

Signed by *Marvin E. Myers*
Surveyor's Michigan License No. 31600

Date *July 31, 1997*