

NOV 03 1998

LAND CORNER RECORDATION CERTIFICATE  
Filing Requirement of Act 74, Mich. P.A. 1970

SECTION

For corners in

<u>Oscoda</u> (County)	Located In:	Corner Code #
1. Public Land Survey	Sec. T <u>27NR 3E</u>	<u>J-3</u>
	Sec. T <u>   </u> R <u>   </u>	<u>   </u>
	T <u>   </u> R <u>   </u>	<u>   </u>
	T <u>   </u> R <u>   </u>	<u>   </u>
2. Property Controlling in Section	S <u>   </u> T <u>   </u> R <u>   </u>	<u>   </u>
	S <u>   </u> T <u>   </u> R <u>   </u>	<u>   </u>
3. Miscellaneous Property in Sec.	S <u>   </u> T <u>   </u> R <u>   </u>	<u>   </u>
	S <u>   </u> T <u>   </u> R <u>   </u>	<u>   </u>
4. Lot No. <u>   </u> , Recorded Plat <u>   </u>		
5. Private Claims <u>   </u>		

*Liber 4 pg 279*

STATE OF MICHIGAN  
OSCODA COUNTY  
FILED

24 SEP 98 11:02 A.M.

PATSY J. PETERS  
REGISTER OF DEEDS  
Register of Deeds Stamp & File  
Number

I, Marvin E. Myers, in a field survey on 19 February, 1998, do hereby state that under requirements of P.A. 74, Michigan P.A. of 1970, the corner points mentioned in lines 1 and 2 above were in conformance with regulations and rules therefore as required in the current manual of survey instructions of the United States Department of the Interior, Bureau of Land Management or by a decree of a Court of Law and /or that the corner points mentioned in lines 3, 4 and 5 above were in conformance with the rules of the Michigan Board of Land Surveyors or by a Decree of a Court of Law; established, re-established, monumented, recovered, found as expressed below:

**NOTE: Not more than 2 corners, all in the same town and range, may be recorded on this certificate.**

A	B	C	D	E	F	G	H	I	J	K	L
1											
2	6	5	4	3	2	1					
3											
4	7	8	9	10	11	12					
5											
6	18	17	16	15	14	13					
7											
8	19	20	21	22	23	24					
9											
10	30	29	28	27	26	25					
11											
12	31	32	33	34	35	36					
13											

A. Description of original monument and accessories and/or subsequent restoration:

G.L.O.  
Oct. 1839  
William R. Coon, D.S.  
Mon: Post  
Wit: 14" Beech N36°E 10 links  
6" Beech S36°W 74 links

Norman C. Caldwell, R.L.S. #12018  
August 7, 1978 Liber 2, Page 638  
LCRC Liber 1, Page 210  
Mon: Found R.R. rail, placed Standard County Corner  
Placed Standard County Corner in line with North - South fence.  
Wit: 10" Maple N20°E 35.3'  
8" Maple N10°W 41.2'

APPROVED

County Remonumentation  
Peer Review Group

*NCC 4 SEPT 98*

Larry G. Beauregard R.L.S.#18654  
May 13, 1997 Liber 197, Page 3533  
Mon: Existing Standard County Corner  
Wit: 12" Maple N20°E 35.3'  
10" Maple N10°W 41.2' (R) 41.04' (M)  
5" Maple N40°E 41.94'  
3" Maple N40°W 49.0'


B. Description of corner evidence found and/or method applied in restoring or reestablishing corner:

Found record Standard County Monument 0.5' deep in centerline Reber Road, left in place.  
Wit: Found 12" Maple with nail and tag in South face N20°E 35.3'  
Found 10" Maple with nail and tag in South face N10°W 41.04'  
Found 3" Maple with spike in SW face N40°W 49.0'  
Found 5" Maple with spike SE face N40°E 41.94'  
Found 16" Locust with MDOT tag in North face S55°W 33.28'  
Found 8" Locust with nail SW face N30°W 29.41'

Accepted Standard County Monument as the best available evidence of the Original Corner.

C. Description of monument for corner and accessories established to perpetuate locating the position of the corner:

1/4 Cor. Sec 2 & 11, T27N, R3E  
Mon - Standard County Monument in gravel roadway.  
Wit: 12" Maple with nail and tag in South face N20°E 35.3'  
10" Maple with nail and tag in South face N10°W 41.04'  
3" Maple with spike in SW face N40°W 49.0'  
5" Maple with spike SE face N40°E 41.94'  
16" Locust with MDOT tag in North face S55°W 33.28'  
8" Locust with nail SW face N30°W 29.41'

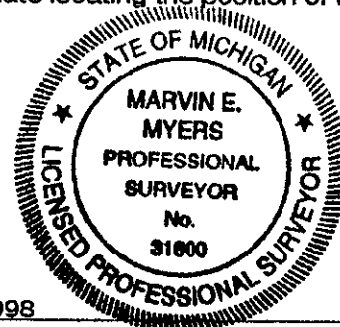

Signed by Marvin E. Myers  
Surveyor's Michigan License No. 31600

Date Aug 17, 1998