

OCT 08 1997

COMMISSION

LAND CORNER RECORDATION CERTIFICATE
Filing Requirement of Act 74, Mich. P.A. 1970

Liber 4 Page 181

For corners in

<u>Oscoda</u> (County)	Located In:	Corner Code #
1. Public Land Survey	T <u>27N</u> , R <u>3E</u>	<u>J-11</u>
	T <u> </u> R <u> </u>	<u> </u>
	T <u> </u> R <u> </u>	<u> </u>
	T <u> </u> R <u> </u>	<u> </u>
2. Property Controlling in Section	S <u> </u> T <u> </u> R <u> </u>	<u> </u>
	S <u> </u> T <u> </u> R <u> </u>	<u> </u>
3. Miscellaneous Property in Sec.	S <u> </u> T <u> </u> R <u> </u>	<u> </u>
	S <u> </u> T <u> </u> R <u> </u>	<u> </u>

STATE OF MICHIGAN
OSCODA COUNTY
FILED

29 AUG 97 9:08 A.M.

PATSY J. PETERS
REGISTER OF DEEDS

Register of Deeds Stamp & File Number

4. Lot No. _____, Recorded Plat _____
5. Private Claims _____

I, Marvin E. Myers, P.S., in a field survey on June 24, 1997 do hereby state that under requirements of P.A. 74, Michigan P.A. of 1970, the corner points mentioned in lines 1 and 2 above were in conformance with regulations and rules therefore as required in the current manual of survey instructions of the United States Department of the Interior, Bureau of Land Management or by a decree of a Court of Law and for that the corner points mentioned in lines 3, 4 and 5 above were in conformance with the rules of the Michigan Board of Land Surveyors or by a Decree of a Court of Law; established, re-established, monumented, recovered, found as expressed below:

NOTE: Not more than 2 corners, all in the same town and range, may be recorded on this certificate.

A	B	C	D	E	F	G	H	I	J	K	L	M
1												
2	6		5		4		3		2		1	
3												
4	7		8		9		10		11		12	
5												
6	18		17		16		15		14		13	
7												
8	19		20		21		22		23		24	
9												
10	30		29		28		27		26		25	
11									●			
12	31		32		33		34		35		36	

A. Description of original monument and accessories and/or subsequent restoration:

GLO - Oct 12, 1839 L. Clason, D.S. Mon- Post Wit: 10" Hemlock N26°E 4 Lks 8" Aspen S32°W 9 Lks	L192, P. 3067 King, P.S. #25852 July 16, 1992 Mon- Found L. Beauregard I & C Wit: none given.
---	--

APPROVED

County Remonumentation
Peer Review Group

NCC/12 AUG 97

LCRC L. 3, P. 97 L. Beauregard, P.S. #18654 Oct 1991
Mon - Set 1/2"x18" Bar & RLS Cap by S.P. method.
3' S. & 3' E. Of Old Fence Corner
Wit: Nail & blaze 15" Cedar N85°W 24.43
Nail & blaze Tw. 6" Cherrys North 3.75
Nail & blaze 8" Cedar N45°E 2.05
Nail & blaze 30" W. Pine S88°E 18.80


L. 5, P. 36 L. Beauregard, P.S. #18654 Oct. 1991
(Same data as recorded in L.3, P. 97 above)

B. Description of corner evidence found and/or method applied in restoring or reestablishing corner:

Found 1/2"x18" rebar and cap; found accessories recorded in L. 3, P. 97 and L.5, P.36 Accepted 1/2" bar as a careful and faithful establishment of the position of the corner. Replaced 1/2" bar with 5/8"x30" rebar and Standard Oscoda Cap.

C. Description of monument for corner and accessories established to perpetuate locating the position of the corner:

1/4 corner common to Sections 26, & 35, T27N, R3E
Mon - Standard Oscoda County Monument
Wit: Found Spike in S. side 15" Cedar N85°W 24.43
Found Spike in W. side 6" Tw. Cherry North 2.05
Found Spike in SE side 8" Cedar N48°E 3.75
Found Spike in E. side 30" W. Pine S88E 18.80

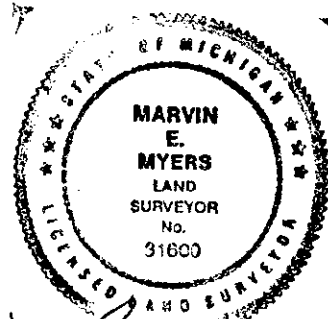

Signed by Marvin E. Myers
Surveyor's Michigan License No. 31600

Date July 31, 1997