

nct 0 8 1**99**7

LAND CORNER RECORDATION CERTIFICATE

liber 4 pg 216

	12 C C C C C C C C C C C C C C C C C C C	IMISSION Elling Bar	MALIT HEODINDATION OFF	III IOATE
г.	- 10	P.A. 1970 STATE OF MICHIGAN		
FO	r corners in			OSCODA COUNTY
	<u> </u>	Located In:	Corner Code #	
	(County)	Comins Twp.	•	FILED
1.	Public Land Survey	т <u>27N</u> в 3	BE K-8	3 OCT 97 12:28 P.H.
		T R _		PLE MP/PLE ME PLEASURE DE
		T R _		PATSY J. PETERS
		T R_		REGISTER OF DEEDS
2.	Property Controlling	ST R_		
	in Section	STR_		
3.	Miscellaneous	S T R _		
	Property in Section	\$ T R_	<u></u>	Register of Deeds Stamp & File Number
4.	Lot No	, Recorded Plat		
		·		A B C D E F G H I J K I
				2 - 6 - 1 - 5 - 1 - 3 - 1 - 2 - 1

Larry G. Beauregard, in a field survey on January do hereby certify that under requirements of P.A. 74, Michigan P.A. of 1970, the corner points mentioned in lines 1 and 2 above were in conformance with regulations and rules therefore as required in the current manual of survey instructions of the United States Department of the Interior, Bureau of Land Management or by a decree of a Court of Law and/or that the corner points mentioned in lines 3, 4 and 5 above were in conformance with the rules of the Michigan Board of Professional Surveyors or by a Decree of a Court of Law; established, re-established, monumented, re-monumented, recovered, found as expressed below:

NOTE: Not more than 4 corners, all in the same town and range, may be recorded on this certificate.

A. Description of original monument and accessories and/or subsequent restoration:

K-8 1 corner for Sections 23 & 24.

Oct. 1839- Lewis Clason D.S., Set post for corner common to Sections 23 & 24. Wit's marked: (Beech 10" N 32° W 9 links) (Beech 10" N 33° E 12 links).

May 1886- John Randall Co. Surveyor, Set post. Wit's marked: (Hemlock 16" N 22° W 55.5 links). No other given.

June 1976- Norman C. Caldwell P.S. #12018, Filed Act #132 Rec. L. 2, P. 291. No wit's marked.

Sept. 1978- Norman C. Caldwell P.S. #12018, Filed Act #132 Rec. L. 2, P. 543. No wit's marked.

Sept. 1978- Norman C. Caldwell P.S. #12018, Fnd. Mon. box 1 bar & cap. Filed Act #74 L.C.R.C. Rec. L.1,P.211. Wit's marked: (South .40' c/1 603) (West 1.70' c/1 Weaver Rd.) (S 50° W 94.25' P.Pole)(S 75° W 38.3' Fe. Post). April 1992- Fred J. King P.S. #25852, Fnd. Rec. Iron in Mon. box. Filed Act #132 Rec. L. 192, P. 1185. No wit's

May 1994 Larry G. Beauregard P.S. #18654. Fnd. 1" bar & RLS cap in Mon. Box. Filed Act #132. Rec. L. 194, P.3603 B. Description of corner evidence found and/or method applied in restoring or reestablishing corner: Wit. Mkd.


Fnd. 1" bar & RLS cap in Mon. box.

Re-placed with 5/8" x 18" bar & 2" aluminum Re-mon cap.

West 33' $\frac{1}{2}$ " bar & cap by F. King. S45°E 57.75' W.leg of Sq. Post. S45°W. 94.55' P. Pole.

N50°W 24.03' Rd. Sg. Post.(Face)

APPROVED

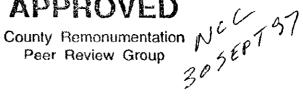

C.	Description of monument for corner and accessories established to perpetuate locating the position of the corner:
	K-8 1 corner for Sections 23 & 24

5/8" x 18" bar & 2" aluminum Oscoda Co. Re-mon cap in Mon. Box. Accepted as the best available evidence of the Annagad his the D

S 50° W 94.51' P.Pole. Placed P.K. nail & P.S. tag., S 70° E 227.48' " " " " " "		STE OF MICH
N 50° E 126.75' 16" Apple. N 65° W 79.1' 11" Spruce		G LARRY G.
Placed 60d spike & P.S. tag #18654 (typ).		BEAUREGARD SURVEYOR S NO. 18654
Signed by Jany D. Beaurgard	Date	9/18/97
Surveyor's Michigan License No. 18654	FORM APPROVE	D BY MICHIGAN STATE BOARD OF PROFESSIONAL SURVEYORS, JAN. 28, 1971 REVISED MAY 14, 1975 REVISED JAN., 1983