

**SURVEY & REMONUMENTATION**

OCT 08 1997

COMMISSION

**LAND CORNER RECORDATION CERTIFICATE**  
Filing Requirement of Act 74, Mich. P.A. 1970

*Liber 4 Page 18C*

For corners in

STATE OF MICHIGAN  
OSCODA COUNTY  
FILED

29 AUG 97 9:17 A.M.

PATSY J. PETERS  
REGISTER OF DEEDS

Register of Deeds Stamp & File Number

<u>Oscoda</u> (County)	Located In:	Corner Code #
1. Public Land Survey	T27N R3E	K-12
	T___ R___	_____
	T___ R___	_____
	T___ R___	_____
2. Property Controlling in Section	S___ T___ R___	_____
	S___ T___ R___	_____
3. Miscellaneous Property in Sec.	S___ T___ R___	_____
	S___ T___ R___	_____

4. Lot No. \_\_\_\_\_, Recorded Plat \_\_\_\_\_  
5. Private Claims \_\_\_\_\_

I, Marvin E. Myers, P.S., in a field survey on April 18, 1997, do hereby state that under requirements of P.A. 74, Michigan P.A. of 1970, the corner points mentioned in lines 1 and 2 above were in conformance with regulations and rules therefore as required in the current manual of survey instructions of the United States Department of the Interior, Bureau of Land Management or by a decree of a Court of Law and for that the corner points mentioned in lines 3, 4 and 5 above were in conformance with the rules of the Michigan Board of Land Surveyors or by a Decree of a Court of Law; established, re-established, monumented, recovered, found as expressed below:

NOTE: Not more than 2 corners, all in the same town and range, may be recorded on this certificate.

	A	B	C	D	E	F	G	H	I	J	K	L	M
1													
2	6		5		4		3		2		1		
3													
4	7		8		9		10		11		12		
5													
6	18		17		16		15		14		13		
7													
8	19		20		21		22		23		24		
9													
10	30		29		28		27		26		25		
11													
12	31		32		33		34		35		36		


A. Description of original monument and accessories and/or subsequent restoration:  
 GLO - Oct 1839 L. Clason, D.S. L.1, P. 386 Sept 12, 1973 Caldwell, P.S. #12018  
 Mon - Post Mon - Set Std. Co. Mon. by single proportion  
 Wit: 6" Aspen N21°E 9 Lks Wit: - not given  
 8" Maple S17°W 24 Lks

1889 J. Randall, Co. Surveyor  
 Mon - Set Post  
 Wit: 30" W. Pine Stub N06°E 51 Lks.  
 8" Lyn. Stump S57°E 16 Lks

**APPROVED**  
County Remonumentation  
Peer Review Group  
*NCC/12 AUG 97*

B. Description of corner evidence found and/or method applied in restoring or reestablishing corner:  
 Found Standard County Monument in intersection of Roads; found nail Se side Utility Pole S52°W 72.3; found 1/2" bar West 33.0; found nail SW side corner fence post S40°E 46.77; found nail in face of Power Pole N36°W 47.18 Accepted Standard County Monument as a careful and faithful establishment of the position of the corner.

C. Description of monument for corner and accessories established to perpetuate locating the position of the corner:  
 1/4 corner common to Sections 35 & 36, T27N, R3E  
 Mon - Standard Oscoda County Monument in intersection of gravel roads N-S & E.  
 Wit: Spike in West side 12" Elm S32°W 74.8  
 Spike in Southwest side Fence Post S40°E 46.77  
 Spike in West side Fence Post N55°E 51.98  
 Spike in East side Power Pole N36°W 47.38

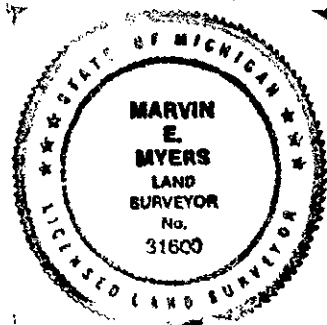

Signed by Marvin E. Myers  
 Surveyor's Michigan License No. 31600

Date July 31, 1997