

SURVEY & REMONUMENTATION

OCT 08 1997

COMMISSION

LAND CORNER RECORDATION CERTIFICATE
 Filing Requirement of Act 74, Mich. P.A. 1970

Liber 4 Page 183

For corners in

<u>Oscoda</u> (County)	Located In:	Corner Code #
1. Public Land Survey	T27N R3E	L-11
	T ___ R ___	_____
	T ___ R ___	_____
	T ___ R ___	_____
2. Property Controlling in Section	S ___ T ___ R ___	_____
	S ___ T ___ R ___	_____
3. Miscellaneous Property in Sec.	S ___ T ___ R ___	_____
	S ___ T ___ R ___	_____

STATE OF MICHIGAN
 OSCODA COUNTY
 FILED

29 AUG 97 9:10 A.M.

PATSY J. PETERS
 REGISTER OF DEEDS

Register of Deeds Stamp & File Number

4. Lot No. _____, Recorded Plat _____
 5. Private Claims _____

I, Marvin E. Myers, P.S., in a field survey on June 24, 19 97 do hereby state that under requirements of P.A. 74, Michigan P.A. of 1970, the corner points mentioned in lines 1 and 2 above were in conformance with regulations and rules therefore as required in the current manual of survey instructions of the United States Department of the Interior, Bureau of Land Management or by a decree of a Court of Law and /or that the corner points mentioned in lines 3, 4 and 5 above were in conformance with the rules of the Michigan Board of Land Surveyors or by a Decree of a Court of Law; established, re-established, monumented, recovered, found as expressed below:

A	B	C	D	E	F	G	H	I	J	K	L	M
1												
2	6		5		4		3		2		1	
3												
4	7		8		9		10		11		12	
5												
6	18		17		16		15		14		13	
7												
8	19		20		21		22		23		24	
9												
10	30		29		28		27		26		25	
11												
12	31		32		33		34		35		36	
13												

NOTE: Not more than 2 corners, all in the same town and range, may be recorded on this certificate.

A. Description of original monument and accessories and/or subsequent restoration:
 GLO - Oct 1839 L. Clason, D.S. L1, P229 Caldwell, P.S. #12018 (Date not given)
 Mon - Post Mon - Not Given
 Wit: 10" Aspen S17°W 10 Lks
 8" Fir N16°E 7 Lks

Section control map
 by N. Caldwell, P.S. #12018 (Date not given)
 Mon- Set 3/4" Pipe by single proportional measure
 Wit: 1/2" Pipe North 33.00
 1/2" Pipe South 33.00

July 14, 1886 J. Randall, Co. Surveyor
 Mon - Not given
 wit: Not given.

APPROVED

County Remonumentation
 Peer Review Group


NCC/12 AUG 97

B. Description of corner evidence found and/or method applied in restoring or reestablishing corner:

Found 3/4"x18" Pipe; found the following accessories 3/4" Pipe N05°E 33.00; 3/4" Pipe S05°W 33.00; 18" poplar S21°W 53.08
 Monument is located at the intersection of Roads, on a fence line going East and is accepted as a careful and faithful establishment of the position of the corner.
 Replaced pipe with 5/8"x30" rebar and Standard Oscoda County Cap.

C. Description of monument for corner and accessories established to perpetuate locating the position of the corner:

1/4 corner common to Sections 25 & 36, T27N, R3E
 Mon - Standard Oscoda county Monument
 Wit: Spike in E. Side 4" Poplar N20°E 74.28
 Spike in SE side 6" Poplar S47°W 26.90
 Spike in N. Side 4" Birch S43°E 17.35
 Spike in E. Side 6" Poplar N25°W 41.65

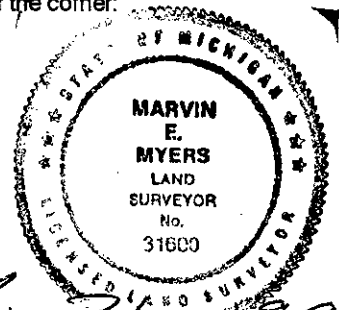

Signed by *Marvin E. Myers*
 Surveyor's Michigan License No. 31600

Date *July 31, 1997*