

NOV 03 1998

LAND CORNER RECORDATION CERTIFICATE
Filing Requirement of Act 74, Mich. P.A. 1970

SECTION

Liber 4 pg 295

For corners in

<u>Oscoda</u> (County)	Located in:	Corner Code #
1. Public Land Survey	Sec. T 27NR 3E	M-3
	Sec. T 27NR 4E	A-3 ✓
	T ___ R ___	_____
	T ___ R ___	_____
2. Property Controlling In Section	S ___ T ___ R ___	_____
	S ___ T ___ R ___	_____
3. Miscellaneous Property in Sec.	S ___ T ___ R ___	_____
	S ___ T ___ R ___	_____
4. Lot No. _____, Recorded Plat _____		
5. Private Claims _____		

STATE OF MICHIGAN
OSCODA COUNTY
FILED

24 SEP 98 11:15 A.M.

PATSY J. PETERS
REGISTER OF DEEDS

Register of Deeds Stamp & File Number

I, Marvin E. Myers, in a field survey on 19 February, 1998 do hereby state that under requirements of P.A. 74, Michigan P.A. of 1970, the corner points mentioned in lines 1 and 2 above were in conformance with regulations and rules therefore as required in the current manual of survey instructions of the United States Department of the Interior, Bureau of Land Management or by a decree of a Court of Law and /or that the corner points mentioned in lines 3, 4 and 5 above were in conformance with the rules of the Michigan Board of Land Surveyors or by a Decree of a Court of Law; established, re-established, monumented, recovered, found as expressed below:

NOTE: Not more than 2 corners, all in the same town and range, may be recorded on this certificate.

A. Description of original monument and accessories and/or subsequent restoration:

G.L.O.
May 1839
Lewis Clason D.S.
Mon: Post
Wit: 14" Yellow Pine S13 3/4°W 29 links
18" Yellow Pine N40 1/4°W 34 links

Edward P. Albertson, County Surveyor
December 1900, Minutes of Survey Sec. 12
Mon: Post 3" Sq. in ground on N. slope of hill
Wit: none provided

	A	B	C	D	E	F	G	H	I	J	K	L			
2		6			5			4			3		2		1
3															
4		7			8			9			10		11		12
5															
6		18			17			16			15		14		13
7															
8		19			20			21			22		23		24
9															
10		30			29			28			27		26		25
11															
12		31			32			33			34		35		36
13															

Norman C. Caldwell, F.L.S. #12018

November 29, 1969 LCRC Liber 2, Page 188

Mon: Found 3/4" Pipe placed by Henning from remains of Original Survey Bearing Trees. Replaced with Standard County Corner.

Wit: 12" Oak S40°W 26.4'
18" Oak S65°E 24.8'

B. Description of corner evidence found and/or method applied in restoring or reestablishing corner:

Found Standard County Corner in line with fence West, on the North slope of hill and 1.5' East of Forest Service Corner marker post w tag.

Wit: Found 16" Oak with blaze S40°W 26.4'
Found 24" Oak with blaze S65°E 24.9'

Accepted as a perpetuation of the Original Government Corner.

C. Description of monument for corner and accessories established to perpetuate locating the position of the corner:

Sec. Cor. Sec. 1 & 12, T27N, R3E and Sec 6 & 7, T27N, R4E


Mon - Standard County Corner in place.

Wit: 16" Oak set spike NE face S40°W 26.98'
24" Oak set spike SW face S65°E 25.80'
16" Oak set spike West face S20°E 17.11'
13" Jack Pine set spike East face N23°E 26.77'

APPROVED

County Remonumentation
Peer Review Group

NCL 4 SEPT 98

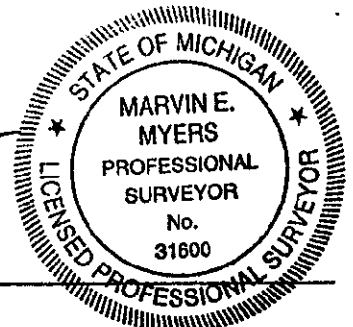

Signed by Marvin E. Myers
Surveyor's Michigan License No. 31600

Date August 25, 1998