

**SURVEY &
REMONUMENTATION**

NOV 03 1998

**LAND CORNER RECORDATION CERTIFICATE
Filing Requirement of Act 74, Mich. P.A. 1970**

For corners in

<u>Oscoda</u> (County)	Located In:	SECTION <u> </u>	Corner Code # <u> </u>
1. Public Land Survey	Sec. <u>T 27NR 3E</u>	<u>M-6</u>	<u> </u>
-	Sec. <u>T 27NR 4E</u>	<u>A-6</u> ✓	<u> </u>
-	T <u> </u> R <u> </u>	<u> </u>	<u> </u>
2. Property Controlling In Section	S <u> </u> T <u> </u> R <u> </u>	<u> </u>	<u> </u>
3. Miscellaneous Property in Sec.	S <u> </u> T <u> </u> R <u> </u>	<u> </u>	<u> </u>
4. Lot No. <u> </u> , Recorded Plat <u> </u>	S <u> </u> T <u> </u> R <u> </u>	<u> </u>	<u> </u>
5. Private Claims <u> </u>	<u> </u>	<u> </u>	<u> </u>

Liber 4 pg 295

STATE OF MICHIGAN
OSCODA COUNTY
FILED

24 SEP 98 11:18 A.M.

Register of Deeds, Stamp & File
Number PRIST J. PETERS
REGISTER OF DEEDS

I, Marvin E. Myers, in a field survey on 19 February, 1998 do hereby state that under requirements of P.A. 74, Michigan P.A. of 1970, the corner points mentioned in lines 1 and 2 above were in conformance with regulations and rules therefore as required in the current manual of survey instructions of the United States Department of the Interior, Bureau of Land Management or by a decree of a Court of Law and /or that the corner points mentioned in lines 3, 4 and 5 above were in conformance with the rules of the Michigan Board of Land Surveyors or by a Decree of a Court of Law; established, re-established, monumented, recovered, found as expressed below:

1	A	B	C	D	E	F	G	H	I	J	K	L	M
2		6		5		4		3		2		1	
3													
4		7		8		9		10		11		12	
5													
6		18		17		16		15		14		13	
7													
8		19		20		21		22		23		24	
9													
10		30		29		28		27		26		25	
11													
12		31		32		33		34		35		36	
13													

NOTE: Not more than 2 corners, all in the same town and range, may be recorded on this certificate.

A. Description of original monument and accessories and/or subsequent restoration:

G.L.O. May 1839 Lewis Clason D.S. Mon: Post Wit: 8" Beech S52 1/2°W 19 links 10" Beech N48°W 19 links	Edward P. Albertson, County Surveyor Dec. 1900, Minutes of Survey Page 176 Mon: Stake in ground Wit: 12" Hemlock S84°43'W 69 1/2 links 14" Hemlock N66°15'
--	--

Norman C. Caldwell R.L.S.#12018 October 16, 1972 Liber 1 Page 256 - 258 LCRC Liber 1 Page 190 Mon: Placed Standard County Corner by SPM No evidence of Albertson Corner Wit: 14" Beech East 49.2' 12" Maple N55°E 54.2' 8" Maple N05°W 52.7' 14" Oak S70°W 26.3' Fence cor. 40' N. & 26' E.	Norman C. Caldwell R.L.S. June 5, 1981 No data available F. King Work performed in Section 18, T27N, R4E Aug 1, 1987 Mon - Found Std. Co. Cor. Wit: None given
--	--

B. Description of corner evidence found and/or method applied in restoring or reestablishing corner:

Found Standard County Corner 28'± West of downed North South fence inline with old clear cut occupation line to the West.
Found 20" Oak with Blaze S72°W 26.3'
Found 12" Maple with Blaze N05°E 52.7'
Found 18" Beech with Blaze East 49.2'
Found 12" Maple Stump N58°E 54.2'
Accepted as a careful and faithful establishment of the position of the Corner.


C. Description of monument for corner and accessories established to perpetuate locating the position of the corner:

1/4 Cor. Sec. 13, T27N, R3E and Sec. 18, T27N, R4E
Mon: Left in place a Standard County Corner
Wit: 20" Oak with Blaze set spike NW face S72°W 27.06"
12" Maple with Blaze set spike E. face N05°E 52.99'
18" Beech with Blaze set spike S. face East 49.74'
12" Maple set spike SE. face N61°E 57.28'

APPROVED

County Remonumentation
Peer Review Group

*NCC
4 SEPT 98*

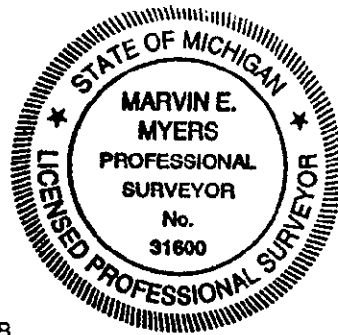

Signed by Marvin E. Myers
Surveyor's Michigan License No. 31600

Date August 25, 1998