

**LAND CORNER RECORDATION CERTIFICATE**  
**Filing Requirement of Act 74, Mich. P.A. 1970**

For corners in

Oscoda

(County)

Located In:

Corner Code ≠

1. Public Land Survey	T	<u>28N</u>	R	<u>1E</u>	<u>C-2</u>		
	T		R				
	T		R				
	T		R				
2. Property Controlling in Section	S	<u>8</u>	T	<u>28N</u>	R	<u>1E</u>	<u>3</u>
	S	<u>5</u>	T	<u>28N</u>	R	<u>1E</u>	<u>10</u>
3. Miscellaneous Property in Sec.	S		T		R		
	S		T		R		

Register of Deeds Stamp & File Number

4. Lot No. \_\_\_\_\_, Recorded Plat \_\_\_\_\_  
 5. Private Claims \_\_\_\_\_

I, Carl R. Johnson, in a field survey on June 22, 19 87, do hereby certify that under requirements of P.A. 74, Michigan P.A. of 1970, the corner points mentioned in lines 1 and 2 above were in conformance with regulations and rules therefore as required in the current manual of survey instructions of the United States Department of the Interior, Bureau of Land Management or by a decree of a Court of Law and/or that the corner points mentioned in lines 3, 4 and 5 above were in conformance with the rules of the Michigan Board of Land Surveyors or by a Decree of a Court of Law; established, re-established, monumented, re-monumented, recovered, found as expressed below:

**NOTE: Not more than 4 corners, all in the same town and range, may be recorded on this certificate.**

A	B	C	D	E	F	G	H	I	J	K	L	M
2	6	5	4	3	2	1						
3												
4	7	8	9	10	11	12						
5												
6	16	17	18	15	14	13						
7												
8	19	20	21	22	23	24						
9												
10	30	29	28	27	26	25						
11												
12	31	32	33	34	35	36						
13												

A. Description of original monument and accessories and/or subsequent restoration:


B. Description of corner evidence found and/or method applied in restoring or reestablishing corner:

- 3 - Set by standard survey procedure for subdivision of a section.  
 10 - Set by standard survey procedure for subdivision of a section.  
 C-2 - Found a 3/4" pipe in place from a previous survey.

C. Description of monument for corner and accessories established to perpetuate locating the position of the corner:

<u>3 - N1/8 Cor. on W. Side</u>	<u>10 - S 1/8, West side</u>
Set 5/8" bar & cedar post	5/8" rod w/cap - cedar post
8" Red Oak S83°W 29.3'	8" Red Pine S75°W 15.7'
7" Red Oak N83°E 4.4'	5" Jack Pine N17°W 7.1'
1 1/2" pipe in conc. N66°W 5.4'	5" Red Oak S55°E 1.5'
<u>C-2 - W 1/4 Cor.</u>	
DNR mon. & cedar post	
7" White Pine S55°W 26.1'	
6" Red Pine N9°W 42.8'	

Signed by Carl R. Johnson  
 Surveyor's Michigan License No. 30083

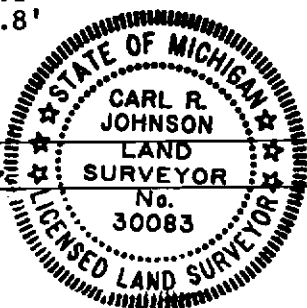

Date 1/4/88