

**1993 OSCODA COUNTY RE-MONUMENTATION  
LAND CORNER RECORDATION CERTIFICATE  
Filing Requirement of Act 74, Mich. P.A. 1970**

For corners in


<u>OSCODA</u> (County)	Located In: <b>GREENWOOD TWP.</b>	Corner Code #:
1. Public Land Survey	T <u>28N</u> R <u>1E</u>	<u>E-8</u>
	T <u>28N</u> R <u>1E</u>	<u>E-9</u>
	T _____ R _____	_____
	T _____ R _____	_____
2. Property Controlling in Section	S _____ T _____ R _____	_____
	S _____ T _____ R _____	_____
3. Miscellaneous Property in Sec.	S _____ T _____ R _____	_____
	S _____ T _____ R _____	_____

Liber 3 pg 182

**FILED**  
At 1:34 o'clock P M  
Date 12-8 1993

Clerk/Registrar of Deeds  
Register of Deeds Stamp & File Number

4. Lot No. \_\_\_\_\_, Recorded Plat \_\_\_\_\_  
5. Private Claims \_\_\_\_\_

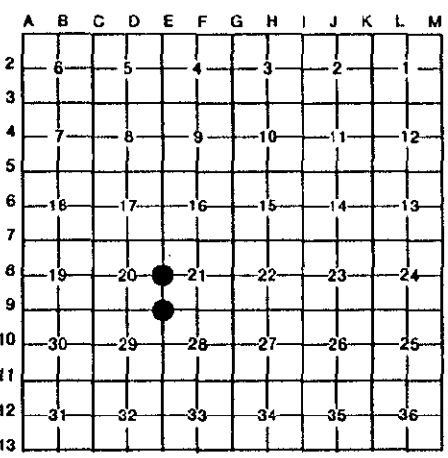

I, Frederick J. King, in a field survey on October, 1993, do hereby certify that under requirements of P.A. 74, Michigan P.A. of 1970, the corner points mentioned in lines 1 and 2 above were in conformance with regulations and rules therefore as required in the current manual of survey instructions of the United States Department of the Interior, Bureau of Land Management or by a decree of a Court of Law and/or that the corner points mentioned in lines 3, 4 and 5 above were in conformance with the rules of the Michigan Board of Land Surveyors or by a Decree of a Court of Law; established, re-established, monumented, re-monumented, recovered, found as expressed below:

**NOTE: Not more than 4 corners, all in the same town and range, may be recorded on this certificate.**

**A. Description of original monument and accessories and/or subsequent restoration:**

- |   |   |
|---|---|
| <b>E-8</b> 1/4 Cor. Common to Sec. 20 & 21, T.28 N., R.1 E.<br>Orig. Post by W. Coon - Dec. 1839<br>S.67°W- 9 lks ( 5.94' ) Spr. Pine<br>N.70°E- 70 lks (46.20' ) Spr. Pine<br>1915 - Sur. by C.O. Seeley - Meas. entire E Tier<br>Set R.R. Fish Plate - S84°W-85 1/2 lks(56.43') Pine<br>1940 - Un-Rec. Sur. by G. Henning-No info on this Cor.<br>1971 - Act 132 Sur. by N. Caldwell - entire Sec.20<br>Rec. L. 1, Pg. 13-15 - No Wit. for this Cor.<br>ACT 74 Rec. Bk. 1, Pg. 43 by N. Caldwell (Aug. 1971)<br>Set Os. Co. P. & C. - S.72°W-58.85'-12" J.Pine<br>S.43°E-32.24'-8" Oak | <b>E-9</b> Cor. Common to Sec. 20, 21, 28 & 29, T.28 N., R.1 E.<br>Orig. Post by W. Coon - Dec. 1839<br>S43°W-10 lks ( 6.60' ) Aspen<br>N43°W- 17 lks (11.22' ) Fir<br>1915 Sur. by C.O. Seeley - Meas. Entire E Tier<br>Set 1 1/2" wd. Trim Strap- N65 1/2°W-29 lks(19.14') Spr. Pine - S29 1/2°W-42 lks(27.72') Spr. Pine<br>1940 Un-Rec. Sur. by G. Henning - No info on this Cor.<br>1971 Act 132 Sur. by N. Caldwell - entire Sec. 20<br>Rec. L. 1, Pg. 13-15 - No Wit for this Cor.<br>ACT 74 Rec. Bk. 1, Pg. 43 by N. Caldwell-Set O.C. P & C<br>ACT 74 Rec. Bk. 1, Pg. 167 by D. Marlatt - Fnd O.C. P&C<br>N80°E-8.6'-14" J.Pine, S.30°E-21.25'-12" J. Pine |
|---|---|

**B. Description of corner evidence found and/or method applied in restoring or reestablishing corner:**

- |   |   |
|---|---|
| <b>E-8</b> 1/4 Cor. Common to Sec. 20 & 21, T.28 N., R.1 E.<br>Fnd. Rec. Oscoda County Pipe & Cap with R.T. Post<br>Area has been clear cut - No Rec. Wit. Fnd. | <b>E-9</b> Cor. Common to Sec. 20, 21, 28 & 29, T.28 N., R.1 E.<br>Fnd. Rec. Oscoda County Pipe & Cap with R.T. Post<br>Fnd. Rec. Marlatt Wit.:N80°E-8.6'-14" J.Pine<br>S30°E-21.25'-12" J. Pine |
|---|---|

PREVIOUS COUNTY SURVEYORS HAVE INDICATED THAT THIS TWP. NOTES ARE FRADULANT-NO EVIDENCE OF ORIGINAL SURVEY FND.

PREVIOUS COUNTY SURVEYORS HAVE INDICATED THAT THIS TWP. NOTES ARE FRADULANT-NO EVIDENCE OF ORIGINAL SURVEY FND.

Approved by Oscoda County Peer Review on October 25, 1993, as a careful and faithful establishment of the position of the corner.

Approved by Oscoda County Peer Review on October 25, 1992, as a careful and faithful establishment of the position of the corner.

**C. Description of monument for corner and accessories established to perpetuate locating the position of the corner:**

- |   |   |
|---|---|
| <b>E-8</b> 1/4 Cor. Common to Sec. 20 & 21, T.28 N., R.1 E.<br>Fnd. Rec. Oscoda County Pipe & Cap<br>N.50°E. - 27.18' - Set Tag SE Sd. 27" J. Pine<br>S.80°E. - 25.56' - Set Tag N. Sd. 12" J. Pine<br>South - 19.72' - Set Tag E. Sd. 15" J. Pine<br>N.50°W. - 1.12' - Set Tag SW Sd. R.T. Post | <b>E-9</b> Cor. Common to Sec. 20, 21, 28 & 29, T.28 N., R.1 E.<br>Fnd. Rec. Oscoda County Pipe & Cap (Bk.1, Pg. 43 & Bk.1, Pg. 167)<br>Corner is @ Fnc. Cor for Fnc. runnin West & South<br>Corner is 19' West of Fnc. running North<br>N.10°E. - 57.20' - Set Tag W. Sd. 15" J. Pine<br>East-(R-N80°E)- 9.30' - Set Tag S. Sd. 18" J. Pine<br>S.15°E.(R-S30°E) - 21.54' - Set Tag S. Sd. 15" J. Pine<br>S.60°W. - 28.61' - Set Tag NW Sd. 15" J. Pine<br>R.T. Post is 1' NW of Corner |
|---|---|

NOTE: All witnesses Marked with Db1. Headed Nails & I.D. Tag #25852

Signed by Frederick J. King Date Dec. 7, 1993  
Surveyor's Michigan License No. 25852

