

LAND CORNER RECORDATION CERTIFICATE
Filing Requirement of Act 74, Mich. P.A. 1970

For corners in Oscoda
 (County)

Located in: _____ Corner Code #/

- | | | |
|------------------------------------|--------------------------|-------------|
| 1. Public Land Survey | T <u>28N</u> R <u>1E</u> | <u>K-13</u> |
| | T _____ R _____ | _____ |
| | T _____ R _____ | _____ |
| | T _____ R _____ | _____ |
| 2. Property Controlling in Section | S _____ T _____ R _____ | _____ |
| | S _____ T _____ R _____ | _____ |
| 3. Miscellaneous Property in Sec. | S _____ T _____ R _____ | _____ |
| | S _____ T _____ R _____ | _____ |

L. 3 pg 195

FILED
 At 8:45 o'clock A M
 Date Dec. 14 19 93

Clark/Register of Deeds
 Register of Deeds Stamp & File Number

4. Lot No. _____, Recorded Plat _____
 5. Private Claims _____

	A	B	C	D	E	F	G	H	I	J	K	L	M
2	6	5	4	3	2	1							
3													
4	7	8	9	10	11	12							
5													
6	18	17	16	15	14	13							
7													
8	19	20	21	22	23	24							
9													
10	30	29	28	27	26	25							
11													
12	31	32	33	34	35	36							
13													

I, Donald E. Marlatt, in a field survey on December 9, 19 93, do hereby certify that under requirements of P.A. 74, Michigan P.A. of 1970, the corner points mentioned in lines 1 and 2 above were in conformance with regulations and rules therefore as required in the current manual of survey instructions of the United States Department of the Interior, Bureau of Land Management or by a decree of a Court of Law and/or that the corner points mentioned in lines 3, 4 and 5 above were in conformance with the rules of the Michigan Board of Land Surveyors or by a Decree of a Court of Law, established, re-established, monumented, re-monumented, recovered, found as expressed below:

NOTE: Not more than 4 corners, all in the same town and range, may be recorded on this certificate.

A. Description of original monument and accessories and/or subsequent restoration:
 (K-13) South Cor. Comm. to Sec's 35 & 36.
 Original Cor. set by Lewis Clawson June 1839.
 Corner fnd. by Seeley Survey June 1915.
 Consumers Power Company Survey Oct. 1967.


B. Description of corner evidence found and/or method applied in restoring or reestablishing corner:
 (K-13) South Cor. Comm. to Sec's 35 & 36.
 Fnd. "T" Iron & 2" pipe (Aslo fnd. North Cor. Comm. to Sec's 1 & 2, 27/1, 33' East).

Peer Group approved as the best available evidence of the re-establishment of the original corner.

Note: Previous Co. Surveyors have indicated that the original Twp. ^{SUB.} notes are fraudulent.

C. Description of monument for corner and accessories established to perpetuate locating the position of the corner:
 (K-13) South Cor. Comm. to Sec's 35 & 36.
 Set Co. Mon.
 N 50° W 13" J. Pine 40.32'
 N 28° W 12" J. Pine 43.0'
 N 48° E 11" J. Pine 26.50'
 S 22° E 12" Oak 46.17'

Note: Witnesses marked with 30 penny spike & I.D. tag #18660.

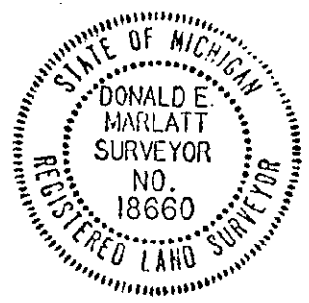

Signed by Donald E. Marlatt Date 12-13-1993
 Surveyor's Michigan License No. 18660