


STATE OF MICHIGAN  
DEPARTMENT  
OF  
NATURAL RESOURCES

LAND CORNER RECORD

OSCODA COUNTY  
T 28 N R 2 E

DESCRIPTION OF CORNER E 1/4 corner Section 10  
CORNER MONUMENT 7-15-71  
DATE MONUMENT PLACED AND WITNESSED Set DNR Department monument  
WITNESSES TO CORNER..... 8" J. Pine S 22 W 11.0'

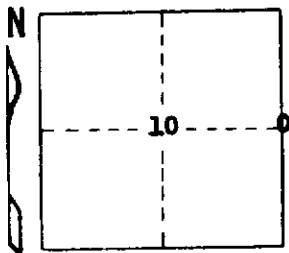


6" J. Pine S 86 E 16.7'  
W. Pine 18" tall S 32 E 5.9'  
AND

CIRCLE CORNER REGISTERED

DESCRIPTION IN DETAIL AS TO HOW CORNER WAS LOCATED AND IDENTIFIED OR RESTORED.

Set corner by proportionate measurement, M.P.O.L. between Section corners.

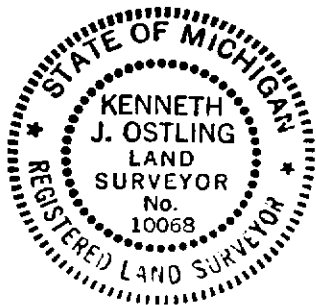

SURVEYOR'S SEAL

SIGNED Kenneth J. Ostling DATE 7-22-71  
REGISTERED LAND SURVEYOR 10068

DISTRIBUTION:

County Courthouse  
Area Forester (Regions I & II)  
District or Region Surveyor  
Forestry Div., Lansing

R 4047  
Rev. 10/68