

STATE OF MICHIGAN
DEPARTMENT
OF
NATURAL RESOURCES

LAND CORNER RECORD


OSCODA COUNTY
T 28 N R 2 & 3 E

DESCRIPTION OF CORNER 1/4 corner common to Sections 1 & 6

CORNER MONUMENT Set Dept. Monument

DATE MONUMENT PLACED AND WITNESSED 5-20-71

WITNESSES TO CORNER.....

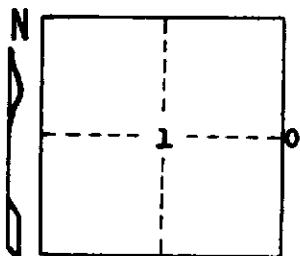

Crooked 7" R. Pine South 81.85'

3" R. Pine S 45 W 31.75'

AND

CIRCLE CORNER REGISTERED

DESCRIPTION IN DETAIL AS TO HOW CORNER WAS LOCATED AND IDENTIFIED OR RESTORED.

This corner was set on line and proportionate distance between Township corner North and Section corner South by M. Schaaf in Mid-1930s. We replaced his pipe in block of concrete with a Department Monument.

SURVEYOR'S SEAL

SIGNED

Ernest J. Oetting

DATE

5-27-71

DISTRIBUTION:

REGISTERED LAND SURVEYOR 10068

County Courthouse
Area Forester (Regions I & II)
District or Region Surveyor
Forestry Div., Lansing