


STATE OF MICHIGAN  
DEPARTMENT  
OF  
NATURAL RESOURCES

LAND CORNER RECORD

OSCODA COUNTY  
T 28 N R 2 E

DESCRIPTION OF CORNER E 1/16 on N. Line, Sec. 10  
CORNER MONUMENT Set 1" x 24" pipe  
DATE MONUMENT PLACED AND WITNESSED 7-15-71  
WITNESSES TO CORNER.....

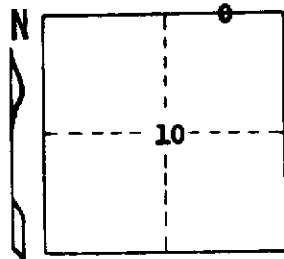


15" R. Pine N 29 W 37.0'  
8" R. Oak S 86 W 22.5'  
AND

CIRCLE CORNER REGISTERED

DESCRIPTION IN DETAIL AS TO HOW CORNER WAS LOCATED AND IDENTIFIED OR RESTORED.

Corner set by standard survey procedures for the subdivision of sections.

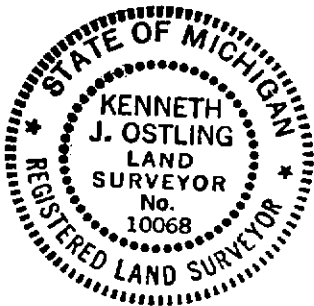

SURVEYOR'S SEAL

DISTRIBUTION:

SIGNED Kenneth J. Ostling DATE 7-22-71  
REGISTERED LAND SURVEYOR #10068

County Courthouse  
Area Forester (Regions I & II)  
District or Region Surveyor  
Forestry Div., Lansing

R 4047  
Rev. 10/68