

STATE OF MICHIGAN
DEPARTMENT
OF
NATURAL RESOURCES
LAND CORNER RECORD


OSCODA COUNTY
T 28 N R 2 E

DESCRIPTION OF CORNER N 1/4 corner, Section 10

CORNER MONUMENT Set DNR Monument

DATE MONUMENT PLACED AND WITNESSED 7-15-71

WITNESSES TO CORNER.....

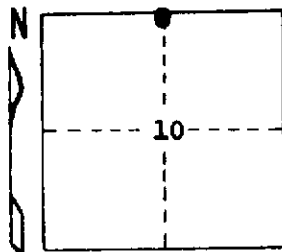

22" R. Pine N 70 W 40.7'


17" R. Pine S 23 E 74.1'

AND

CIRCLE CORNER REGISTERED

DESCRIPTION IN DETAIL AS TO HOW CORNER WAS LOCATED AND IDENTIFIED OR RESTORED.

Corner set by proportionate measurement, M.P.O.L. between section corners. No previous corner.

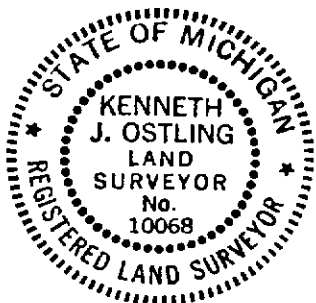

SURVEYOR'S SEAL

SIGNED

Kenneth J. Ostling
REGISTERED LAND SURVEYOR
10068

DATE

7-22-71

DISTRIBUTION:

County Courthouse
Area Forester (Regions I & II)
District or Region Surveyor
Forestry Div., Lansing

R 4047
Rev. 10/68