


STATE OF MICHIGAN
DEPARTMENT
OF
NATURAL RESOURCES

LAND CORNER RECORD

OSCODA COUNTY
T 28 N R 2 E

DESCRIPTION OF CORNER S 1/4 corner, Section 2
CORNER MONUMENT Set DNR Monument
DATE MONUMENT PLACED AND WITNESSED 7-14-71
WITNESSES TO CORNER.....

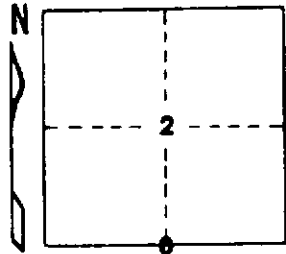


9" Maple S 36 W 26.8'
8" Maple S 41 E 18.6'
AND

CIRCLE CORNER REGISTERED

DESCRIPTION IN DETAIL AS TO HOW CORNER WAS LOCATED AND IDENTIFIED OR RESTORED.

Corner set by proportionate measurement, M.P.O.L., between section corners. No previous corner.

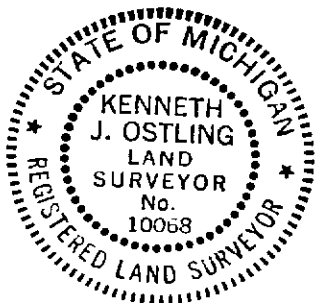

SURVEYOR'S SEAL

SIGNED Kenneth J. Ostling DATE 7-21-71
REGISTERED LAND SURVEYOR #10068

DISTRIBUTION:

County Courthouse
Area Forester (Regions I & II)
District or Region Surveyor
Forestry Div., Lansing

R 4047
Rev. 10/68