

MICHIGAN
DEPARTMENT OF CONSERVATION
FORESTRY DIVISION

LAND CORNER RECORD

T. 28 N.R. 2 E


Oscoda COUNTY

DESCRIPTION OF CORNER 1/4 corner common to Sections 31-32

CORNER MONUMENT Set Cons. Dept. Monument

DATE MONUMENT PLACED AND WITNESSED 8/30/68

WITNESSES TO CORNER.....

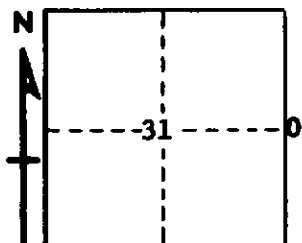

20" R. Pine N 13 E 95.7'

9" R. Pine S 73 E 39.2'

AND

CIRCLE CORNER REGISTERED

DESCRIPTION IN DETAIL AS TO HOW CORNER WAS LOCATED AND IDENTIFIED OR RESTORED.

This corner was found during a survey of Section 31. Found Schaaf pipe at corner, which check record of previous surveys by County Surveyor.

SURVEYOR'S SEAL

SIGNED *Ernest J. Orthog* DATE 9/5/68
REGISTERED LAND SURVEYOR

#10068