

MICHIGAN
DEPARTMENT OF CONSERVATION
FORESTRY DIVISION

LAND CORNER RECORD

T. 28 N.R. 2 E


OSCODA COUNTY

DESCRIPTION OF CORNER Section corner common to Sections 32-33 on South Boundary

CORNER MONUMENT Set DNR Monument - 1" pipe with 4" Alum. Cap.

DATE MONUMENT PLACED AND WITNESSED 5-13-69

WITNESSES TO CORNER..... 12" B. Oak N 35 W 17.4'

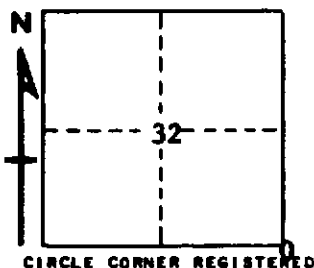

Old NBT 20" W. Pine N 65 E 81.6'

USBT 16" Y. Pine Stp. N 15 W 34.3'

AND

USBT 14" Y. Pine Stp N 44 E 20.4'

DESCRIPTION IN DETAIL AS TO HOW CORNER WAS LOCATED AND IDENTIFIED OR RESTORED.

This corner was found during a general retracement in this area. Found 1½" pipe with concrete base in place as previously established by Marcus Schaaf. Both U.S.B.T. stumps in place with good faces. One of few original corners left in this township.

SURVEYOR'S SEAL

SIGNED *Kenneth J. Ostling* DATE 6/9/69
REGISTERED LAND SURVEYOR 10068